

CU-07

Form 2

CU Certification of Completion

CU BACKFILL/ENGINEERED CAP COMPLETION APPROVAL - FORM 2						
Reporting Date	11/19/2009				Placement Start Date	10/18/2009
CU Number	7				Placement End Date	11/8/2009
Approximate CU Centroid	Northing	1615503.004	Easting	734592.065	NY State NAD 83	
CU Size	4.71	Acres				
Backfill Area	3.75	Acres				
Cap Area	0.96	Acres				
Backfill Surface Mean Tri+ PCBs Concentration (when required)		NA		mg/kg		
Number of nodes sampled		NA		mg/kg		
Backfill X	Type of Backfill Type 1, Type 2, Nearshore, 15%	Reference to appropriate drawings attached to Approval Form 1 CU7 Backfill and Cap Plan, 10/24/09				
Cap X	Type of Cap Type "A" Low Velocity Cap and Type "A" Medium to High Velocity Cap	Reference to appropriate drawings attached to Approval Form 1 CU7 Backfill and Cap Plan, 10/24/09				
CU Checklist		Indicate one of the following			Reviewer Initial Acceptance	
Item	Attached	Not Applicable	GE	EPA		
Drawing of Installed Backfill/Cap (with record details, thickness and sample locations [when backfill/cap are placed])	x					
Where applicable in backfill areas provide the following: Sample locations (coordinates), depths, Aroclor and Tri+ PCB concentrations collected including analytical data, field observations, (hard copy and electronic copies [in database format or equivalent])		x				
Comments						
Refer to attached Narrative Backfill and Capping Summary and CU 7 Backfill and Cap Drawings. *Backfill Area does not include 15% backfill material placed over Cap Area.						
Upon signing this document, GE certifies that the backfill/cap has been installed satisfactorily and that no further backfill placement or capping is required for this CU. These remedial activities exclude long term operation, monitoring, maintenance and adaptive management at the CU. EPA accepts this certification.						
Signature of GE Representative			Signature of EPA Representative			
Signature			Signature			
Name			Name			
Date			Date			

Narrative

CU 7

Narrative Summary of Backfill and Capping and EPA Backfill and Capping Agreements

1.0 Cap Placement

A Type "A" Medium to High Velocity Cap and a Type "A" Low Velocity Cap was placed in accordance with the CU 7 Backfill and Capping Plan Drawing, dated October 24, 2009, which was provided to EPA as part of the CU 7 Form 1 package. A multi-beam bathymetric survey of the CU 7 cap was performed after final cap placement on October 28 and November 9, 2009, as shown on the attached CU 7 Type "A" Cap Acceptance Survey, dated November 14, 2009. The surveyed cap thickness on a 5' x 5' grid is shown for all cap areas. Cap thicknesses for the Type "A" Low Velocity Cap includes 15% and near shore Type 2 material, as discussed at the October 29, 2009 daily data meeting.

2.0 Backfill Placement

Backfill materials were placed in accordance with the CU 7 Backfill and Capping Plan Drawing, dated October 24, 2009, provided to EPA as part of the CU 7 Form 1 package. Multi-beam bathymetric surveys for CU 7 were performed after backfill placement on October 28 and November 8, 2009, as shown on the attached CU 7 Backfill Placement Acceptance Drawing, dated November 19, 2009. The difference to backfill prism on a 10' x 10' grid is shown for all backfill areas.

3.0 EPA Field Agreements Specific to CU 7 Backfill and Capping

1. During the 4:00 PM meeting on October 12, 2009, EPA agreed that acceptance surveys of partial areas of a CU may be performed and used for acceptance once placement of backfill or cap in those areas is complete.
2. During a 3:00 PM meeting with EPA on November 12, 2009, GE presented acceptance surveys of the difference to backfill prisms on a 10' x 10' grid in CU 7. GE also presented the Cap Acceptance Survey Drawing during the meeting of November 12, 2009. EPA agreed that the top of cap and backfill elevations, as shown, were acceptable (see attached e-mail, dated November 14, 2009). The Cap Acceptance Survey Drawing, dated November 14, 2009 is included in this package.

Tables

Table 1. CU-7 - All Near-Shore Topographic Measurements

Published Near-Shore Border Set Points				Near-Shore Topographic Measurements				
Name	Easting	Northing	Target Elevation	Easting	Northing	Check Elevation	Horz. Dist	Vert Diff.
7-1	734,613.43	1,615,795.99	117.50	734,613.73	1,615,796.57	115.89	0.64	-1.61
				734,612.43	1,615,800.02	117.02	4.15	-0.48
				734,613.88	1,615,802.72	118.57	6.74	1.07
				734,614.21	1,615,804.34	119.33	8.38	1.83
7-2	734,689.91	1,615,743.93	117.50	734,690.00	1,615,743.55	117.31	0.39	-0.19
7-3	734,760.29	1,615,690.00	117.50	734,760.24	1,615,690.31	118.08	0.31	0.58
7-4	734,830.83	1,615,631.68	117.50	734,830.69	1,615,631.68	115.85	0.14	-1.65
				734,831.85	1,615,635.02	116.99	3.49	-0.51
				734,833.85	1,615,637.10	117.90	6.21	0.40
				734,835.53	1,615,637.48	118.59	7.47	1.09
7-5	734,900.55	1,615,576.79	117.50	734,900.07	1,615,576.26	116.21	0.72	-1.29
				734,902.49	1,615,578.10	117.18	2.33	-0.32
				734,904.72	1,615,582.63	119.18	7.17	1.68
7-6	734,311.00	1,615,480.13	117.50	734,310.35	1,615,480.28	117.81	0.67	0.31
7-7	734,338.46	1,615,433.72	117.50	734,338.20	1,615,434.00	118.05	0.38	0.55
7-8	734,385.69	1,615,379.54	117.50	734,385.84	1,615,379.50	118.64	0.15	1.14
				734,385.78	1,615,377.11	119.19	2.43	1.69
				734,389.25	1,615,380.89	118.23	3.81	0.73
				734,392.11	1,615,384.03	117.30	7.84	-0.20
7-9	734,412.60	1,615,372.47	117.50	734,412.89	1,615,372.36	117.66	0.31	0.16
7-10	734,440.72	1,615,336.72	117.50	734,440.84	1,615,336.78	118.27	0.13	0.77
				734,438.41	1,615,334.51	119.07	3.20	1.57
				734,442.68	1,615,339.73	117.53	3.58	0.03
				734,444.10	1,615,341.19	117.06	5.60	-0.44
7-11	734,455.54	1,615,292.63	117.50	734,455.70	1,615,292.65	118.59	0.16	1.09
				734,458.66	1,615,295.25	117.75	4.07	0.25
				734,460.07	1,615,296.63	116.98	6.04	-0.52
				734,453.26	1,615,289.07	118.86	4.23	1.36
				734,452.94	1,615,288.00	119.13	5.32	1.63
7-12	734,521.22	1,615,217.40	117.50	734,516.46	1,615,223.67	116.77	7.87	-0.73
				734,510.58	1,615,220.61	118.79	11.11	1.29

Notes:

1. Measurements Collected on the 11th of November 2009 using standard land survey methods.
2. At near shore set point locations where the set point elevation was not at tolerance, additional measurements were taken at nearby locations to provide additional information.

Figures




CU7 TYPE A CAP PLACEMENT



- NOTES:**
- OSI MULTIBEAM SURVEYS ON OCTOBER 28 & NOVEMBER 9, 2009.
 - CAP THICKNESS IS LISTED IN 5'x5' GRIDS.
 - CAP THICKNESS SHOWN INCLUDES 15% BACKFILL TYPE 2 MATERIAL PLACED OVER TYPE "A" LOW VELOCITY CAP AS DISCUSSED AT THE OCTOBER 29, 2009 DATA MEETING.
 - CAP THICKNESS SHOWN INCLUDES NEAR SHORE BACKFILL TYPE 2 MATERIAL PLACED OVER TYPE "A" LOW VELOCITY CAP AS DISCUSSED AT THE OCTOBER 29, 2009 DATA MEETING.

LEGEND	
	5'x5' GRID WITHIN DESIGN GUIDELINES
	5'x5' GRID LESS THAN DESIGN GUIDELINES
	5'x5' GRID ABOVE DESIGN GUIDELINES
	CU BOUNDARY
	CU SUBUNIT BOUNDARY
	MUD - RIP RAP INTERFACE
	5' INTERFACE OFFSET
	NEARSHORE BORDER (117.5 FEET)

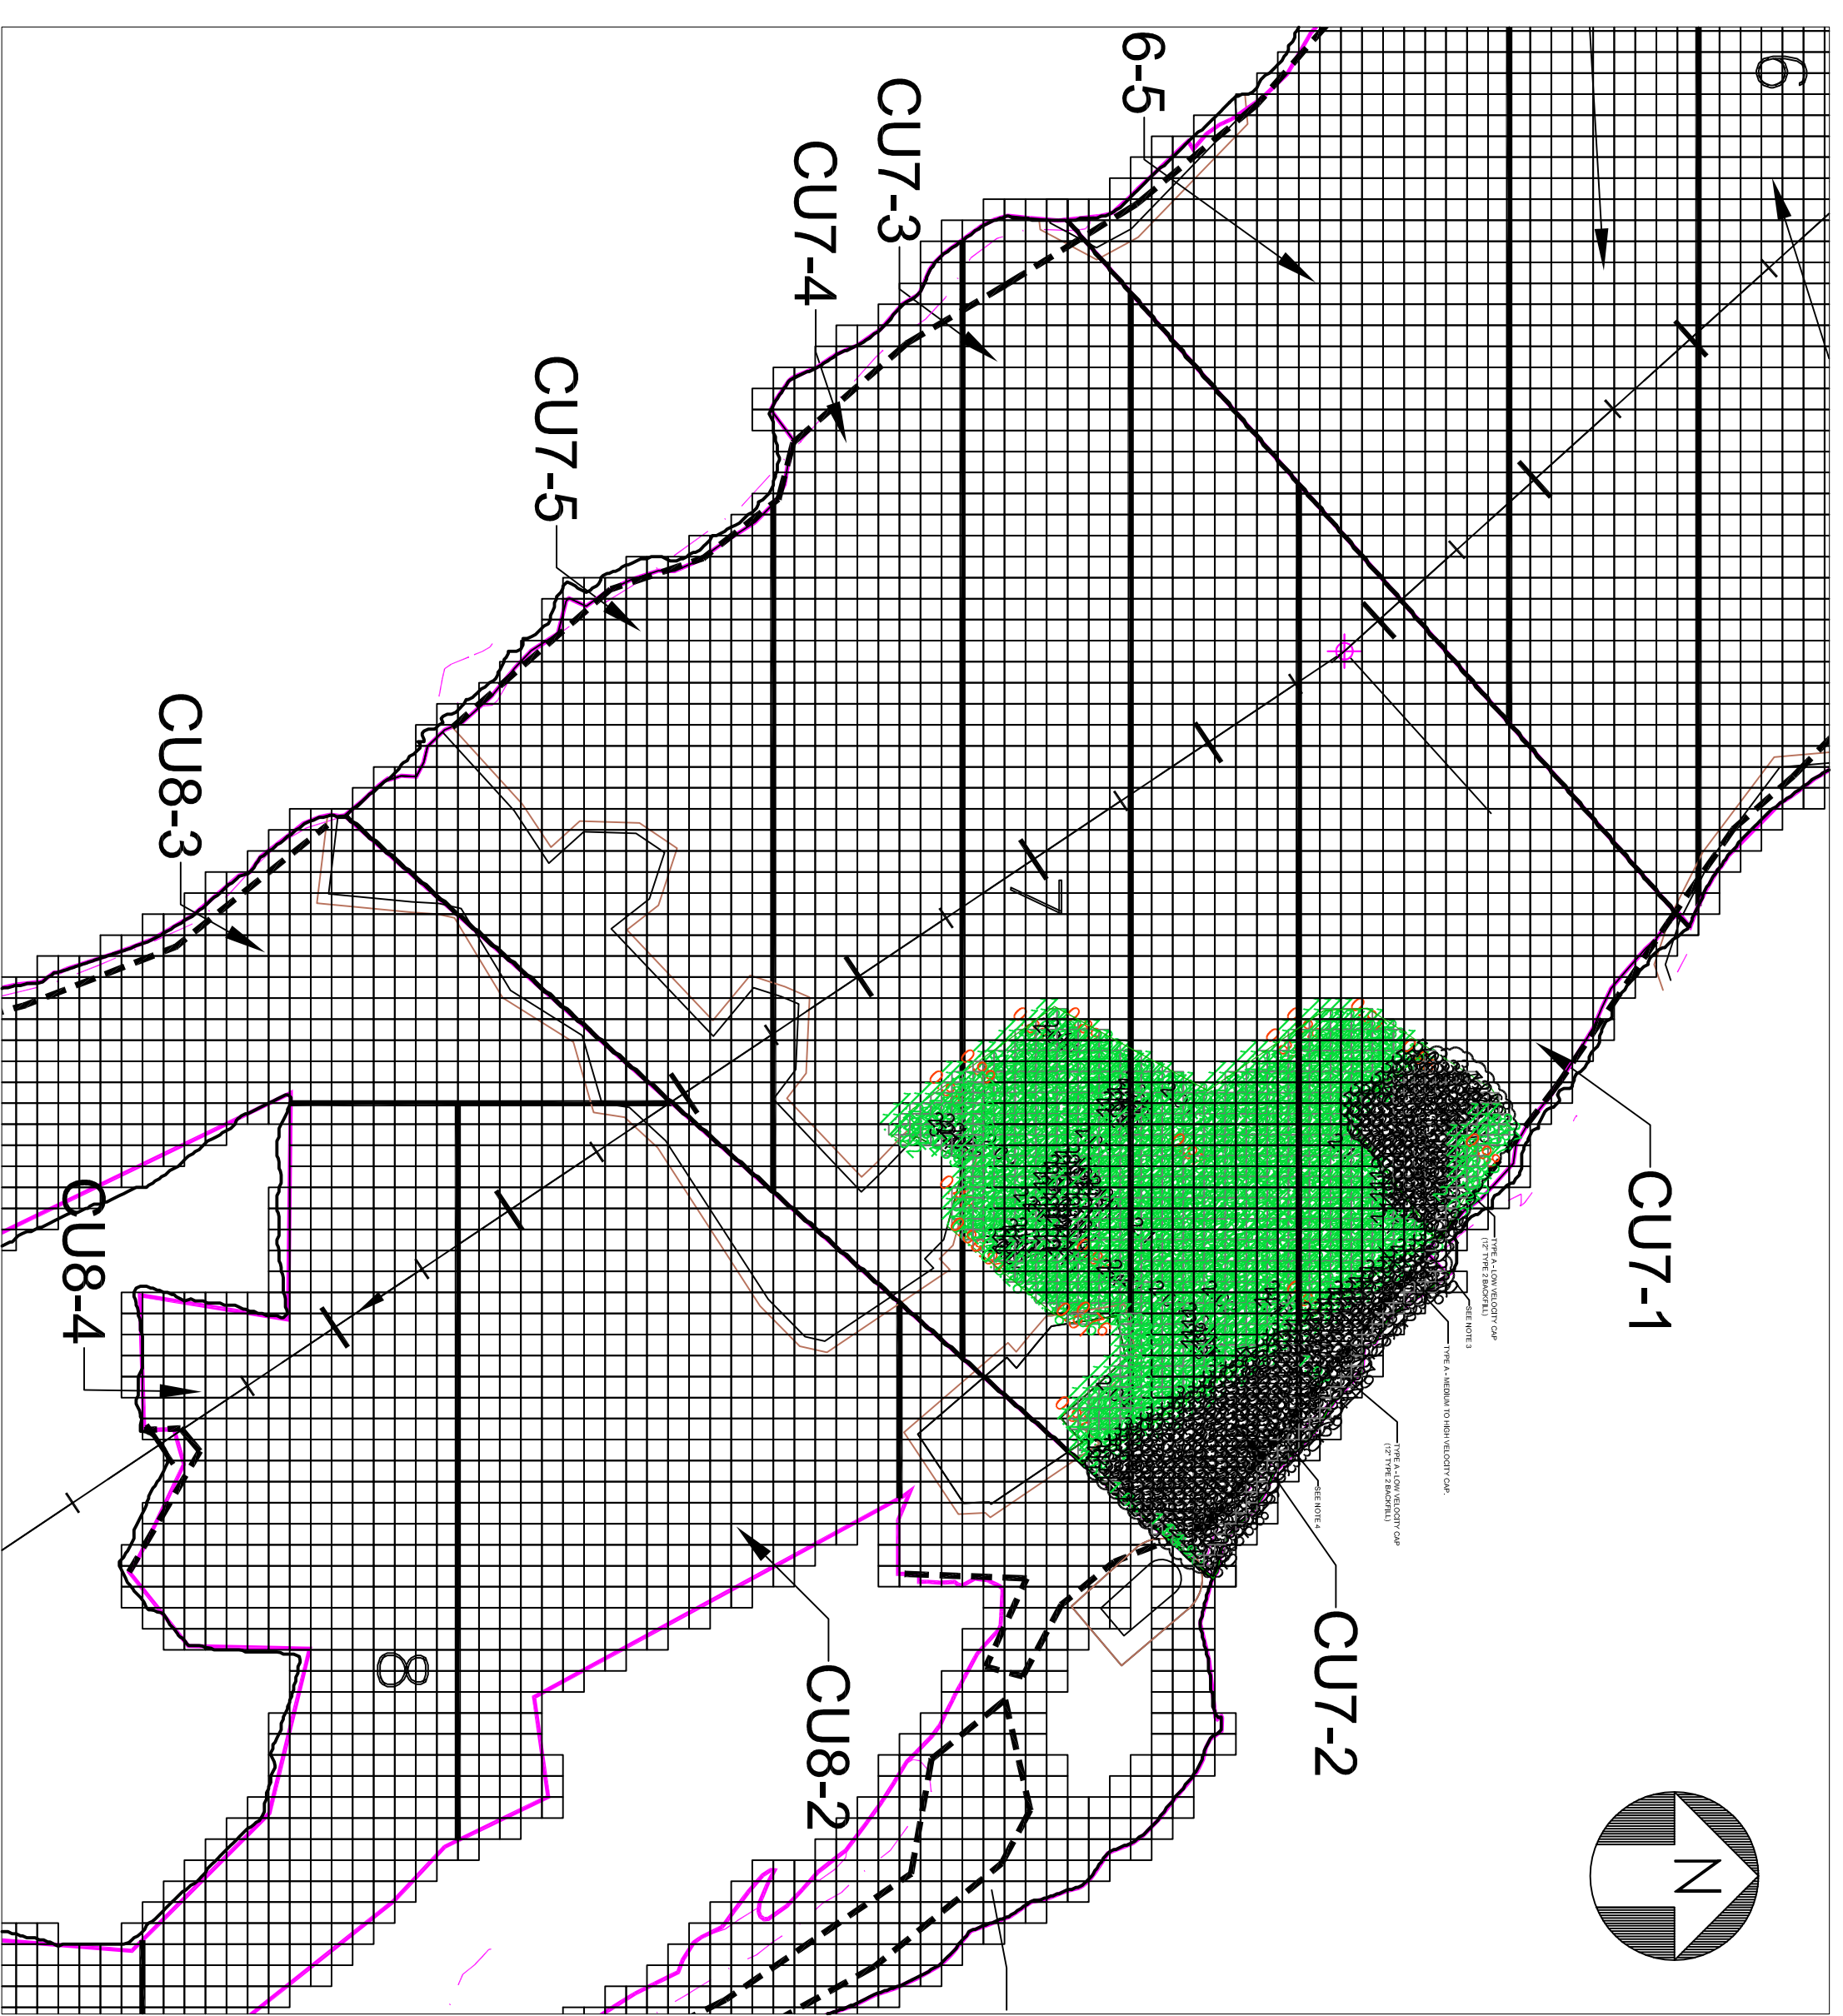

CU7 TYPE A CAP LOCATION


CU-7
 TYPE A CAP
 ACCEPTANCE SURVEY

0	11/14/09	JHG	ACCEPTANCE SURVEY	MG
REV	DATE	DRN BY	DRAWING DESCRIPTION	PM
PARSONS				
GE COMPANY - PARSONS PROJECT OFFICE				
BUILDING 40-1, 381 BROADWAY				
FORT EDWARD, N.Y. 12828 (518) 746-5311				
DRAWN BY	JHG	CHECKED BY	JHG	DRAWING NO.
DATE	11/14/09	APPROVED BY	MG	CU7-3
				SCALE: AS SHOWN
				442209.01401


LEGEND

- CU BOUNDARY
- CU SUBUNIT BOUNDARY
- MUD - RIP RAP INTERFACE
- 5' INTERFACE OFFSET
- 1 FOOT BACKFILL AND NEARSHORE PLACEMENT TYPE 1 MATERIAL
- 1 FOOT BACKFILL AND NEARSHORE PLACEMENT TYPE 2 MATERIAL
- 15% BACKFILL PLACEMENT TO AN ELEV. OF 114.0 FEET TYPE 1 MATERIAL
- 15% BACKFILL PLACEMENT TO AN ELEV. OF 114.0 FEET TYPE 2 MATERIAL
- 15% BACKFILL PLACEMENT TO ORIGINAL BATHYMETRY TYPE 1 MATERIAL
- 15% BACKFILL PLACEMENT TO ORIGINAL BATHYMETRY TYPE 2 MATERIAL
- TYPE A - LOW VELOCITY CAP (12" TYPE 2 BACKFILL)
- TYPE A - MEDIUM TO HIGH VELOCITY CAP.
- 7-12 NEARSHORE BORDER SET POINT
- POTENTIAL LOCATION FOR RIVERINE FRINGING WETLAND CONSTRUCTION (PLANTING BY OTHERS)
- LIMIT OF NON-COMPLIANT NODE POLYGONS.

- NOTES:**
- BACKFILL TO BE PLACED IN ACCORDANCE WITH SECTION 13720 AND DESIGN DRAWINGS B-0021-SK1 AND B-0020-SK1.
 - CAP MATERIALS TO BE PLACED IN ACCORDANCE WITH SECTION 13720 AND DESIGN DRAWING C-0038.
 - PLACEMENT OF NEARSHORE BACKFILL IN TYPE 1 AREAS TO CONSIST OF TYPE 2 BACKFILL TO EL. 116.5', THEN TYPE 1 BACKFILL FROM EL. 116.5' TO 119'. (SEE SKETCH CUT-BF-01)
 - BACKFILL IN THIS AREA TO BE PLACED IN ACCORDANCE WITH TYPICAL RIVERINE FRINGING WETLAND CROSS SECTION AS SHOWN ON CONTRACT DRAWING B-0021-SK1.
 - THE PORTION OF THE WETLAND THAT HAS BEEN IMPACTED BY DREDGING WILL NOT BE RESTORED IN PLACE, BUT MITIGATION WILL CONSIST OF CREATION OF WETLAND IN CUR SAND BAR AREA (1:1 BY AREA, PER OCTOBER 20, 2008 DAILY DATA MEETING).
 - TOTAL CAP AREA INCLUDES 5' HORIZONTAL OFFSET INTO COMPLIANT AREA, AS PER DRAWING C-0038.
 - LIMIT OF CAP AT 5 FT. HORIZONTAL OFFSET FROM LIMIT OF NON-COMPLIANT NODE POLYGON.

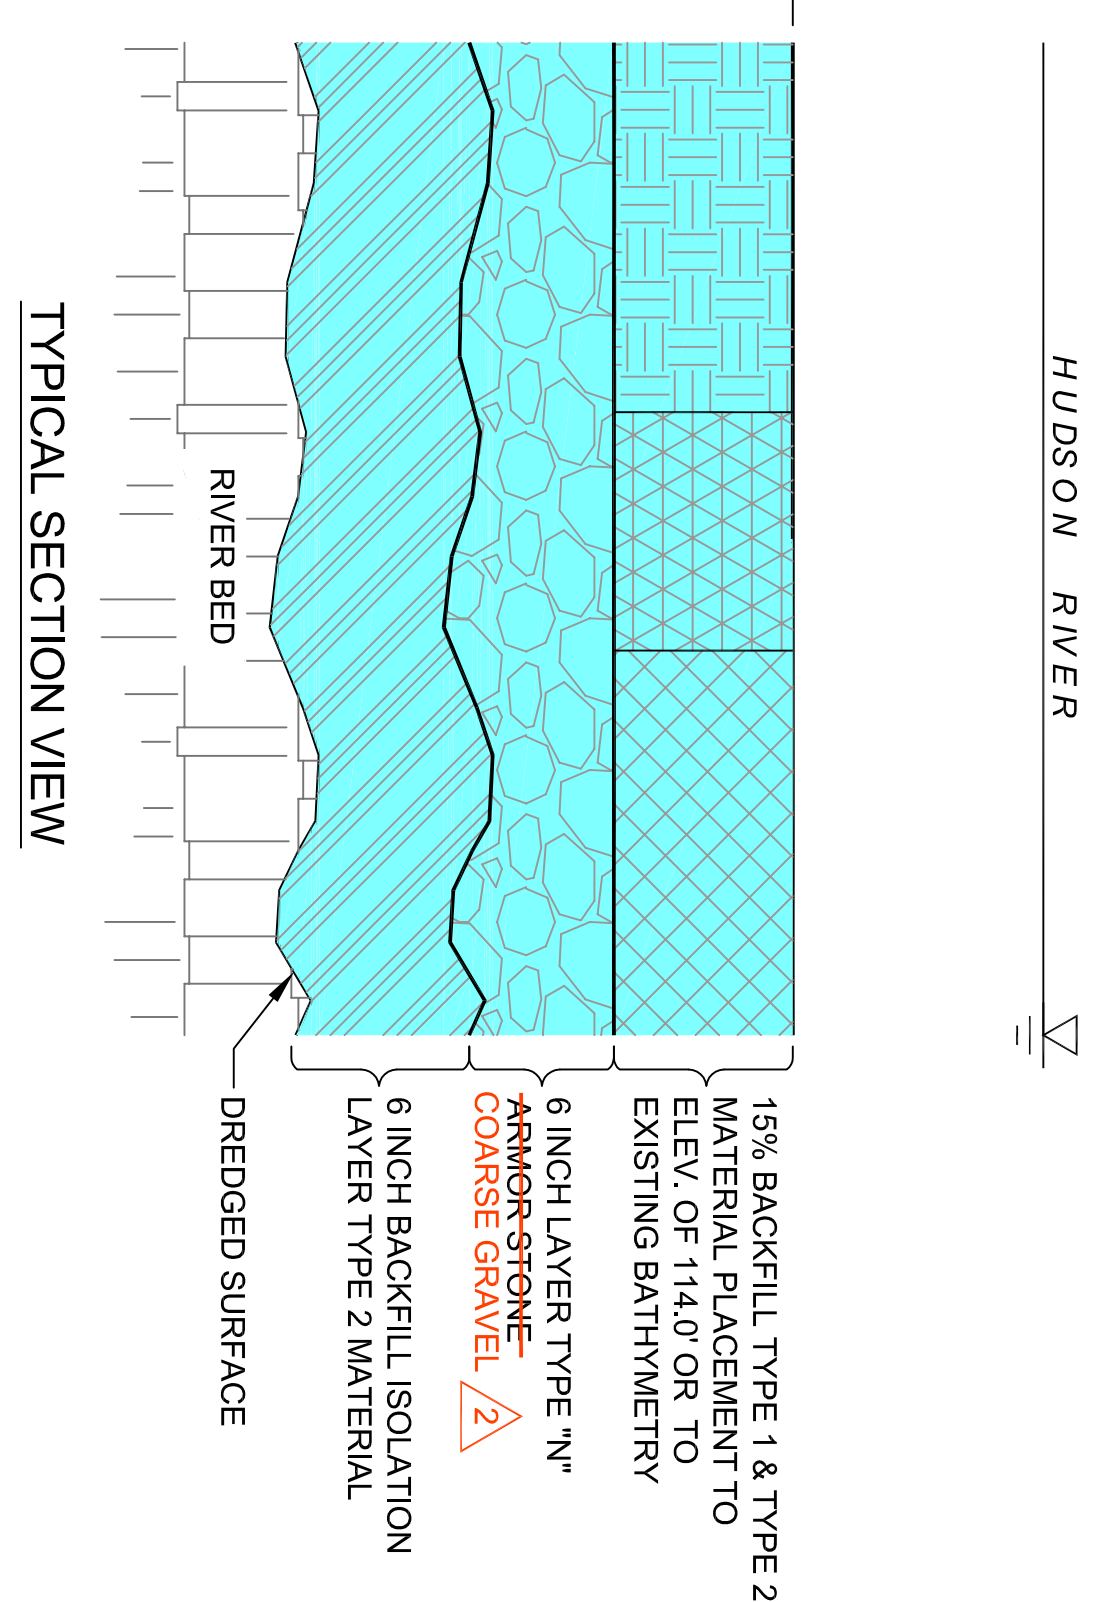



DETAIL 1 - TYPE "A" MEDIUM TO HIGH VELOCITY CAP CUT
NOT TO SCALE


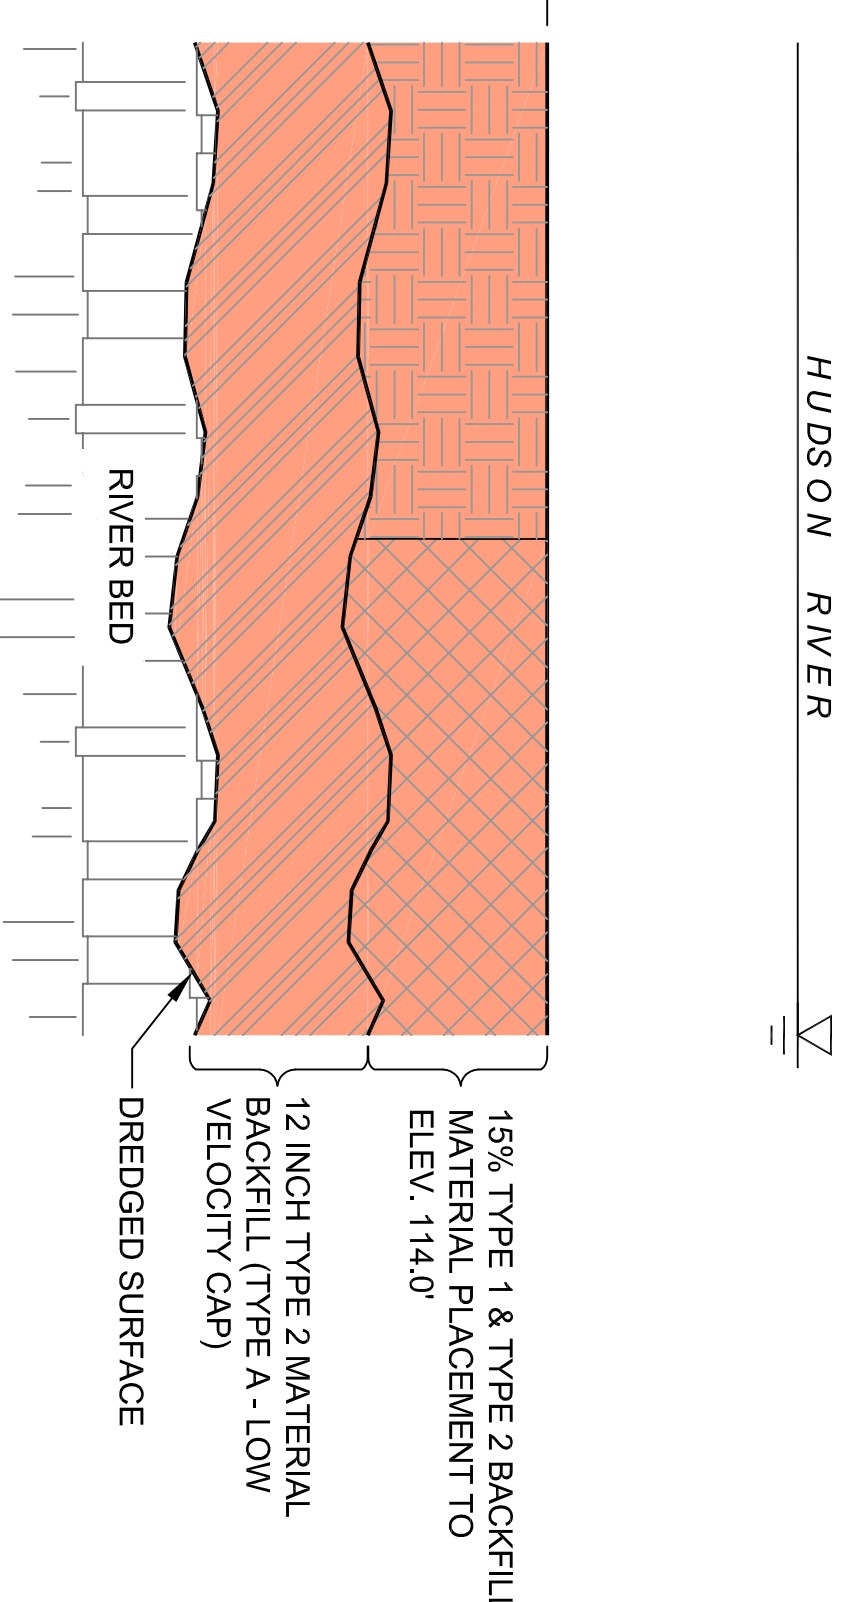


DETAIL 2 - TYPE "A" LOW VELOCITY CAP CUT
NOT TO SCALE

RECORD DRAWING

BATHYMETRY USED FROM OSI MULTIBEAM SURVEY DATA ON OCTOBER 12, 2009

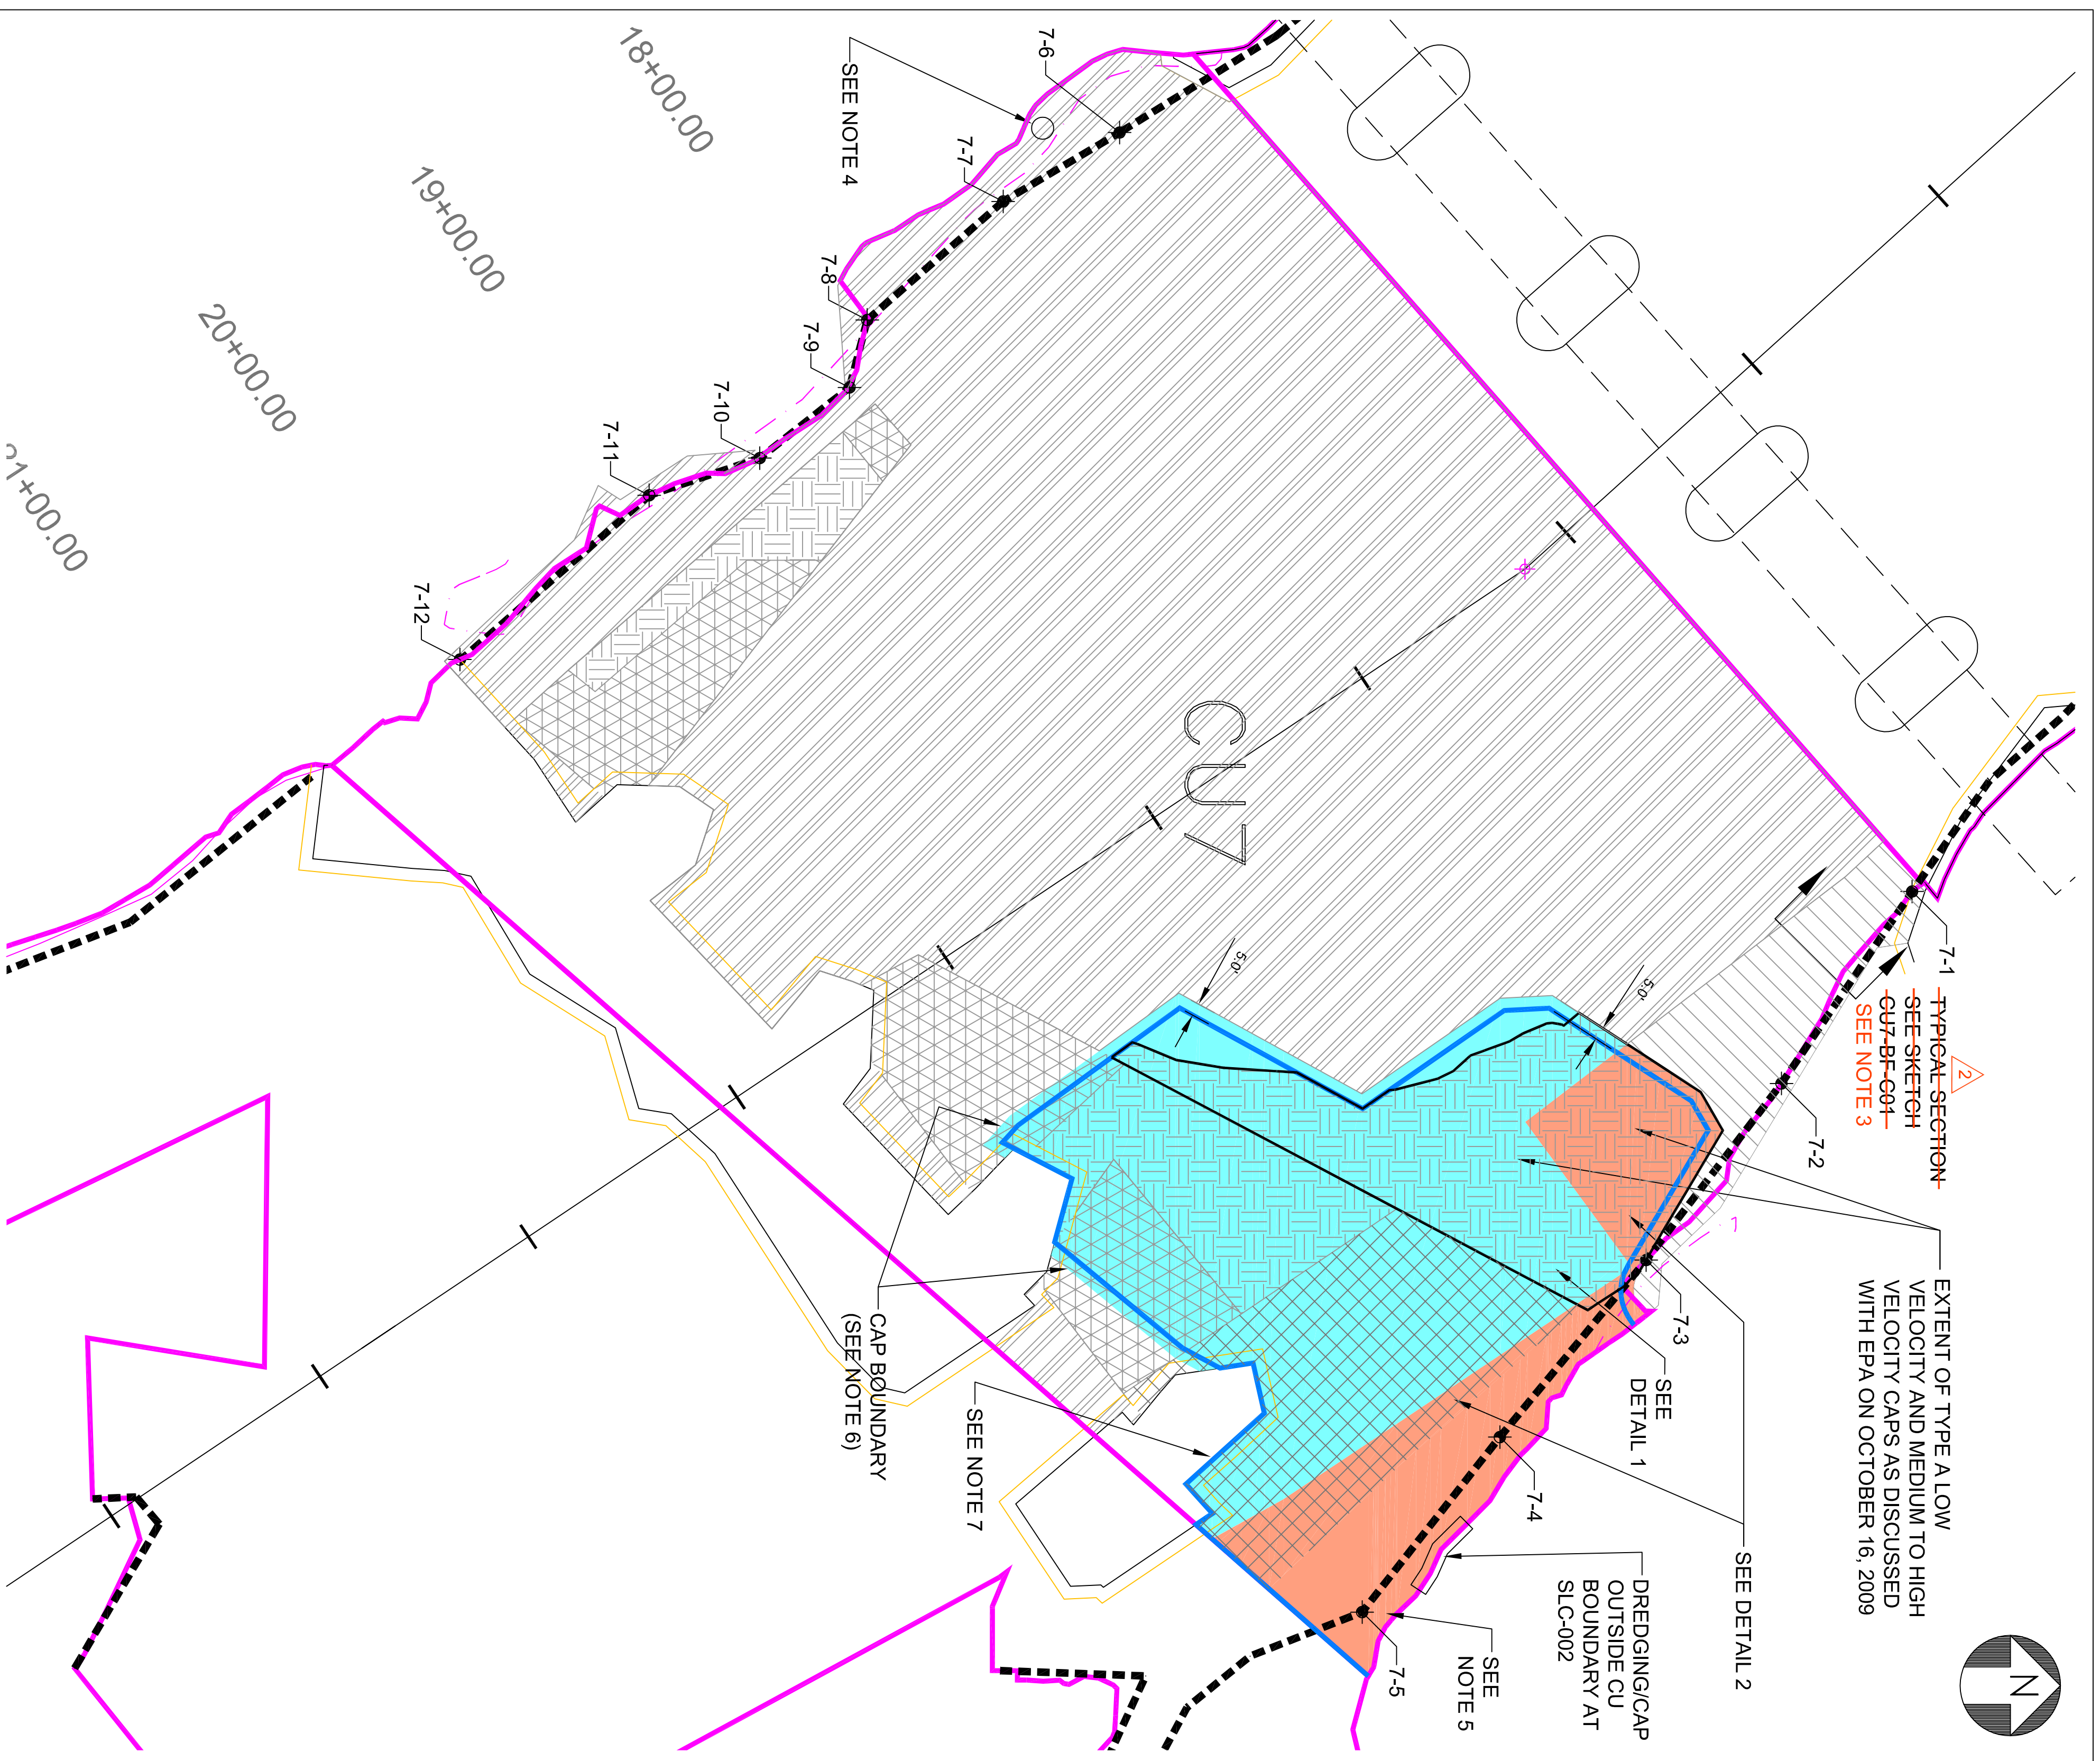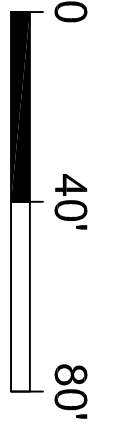

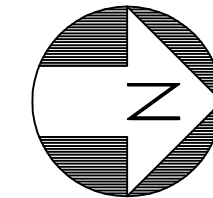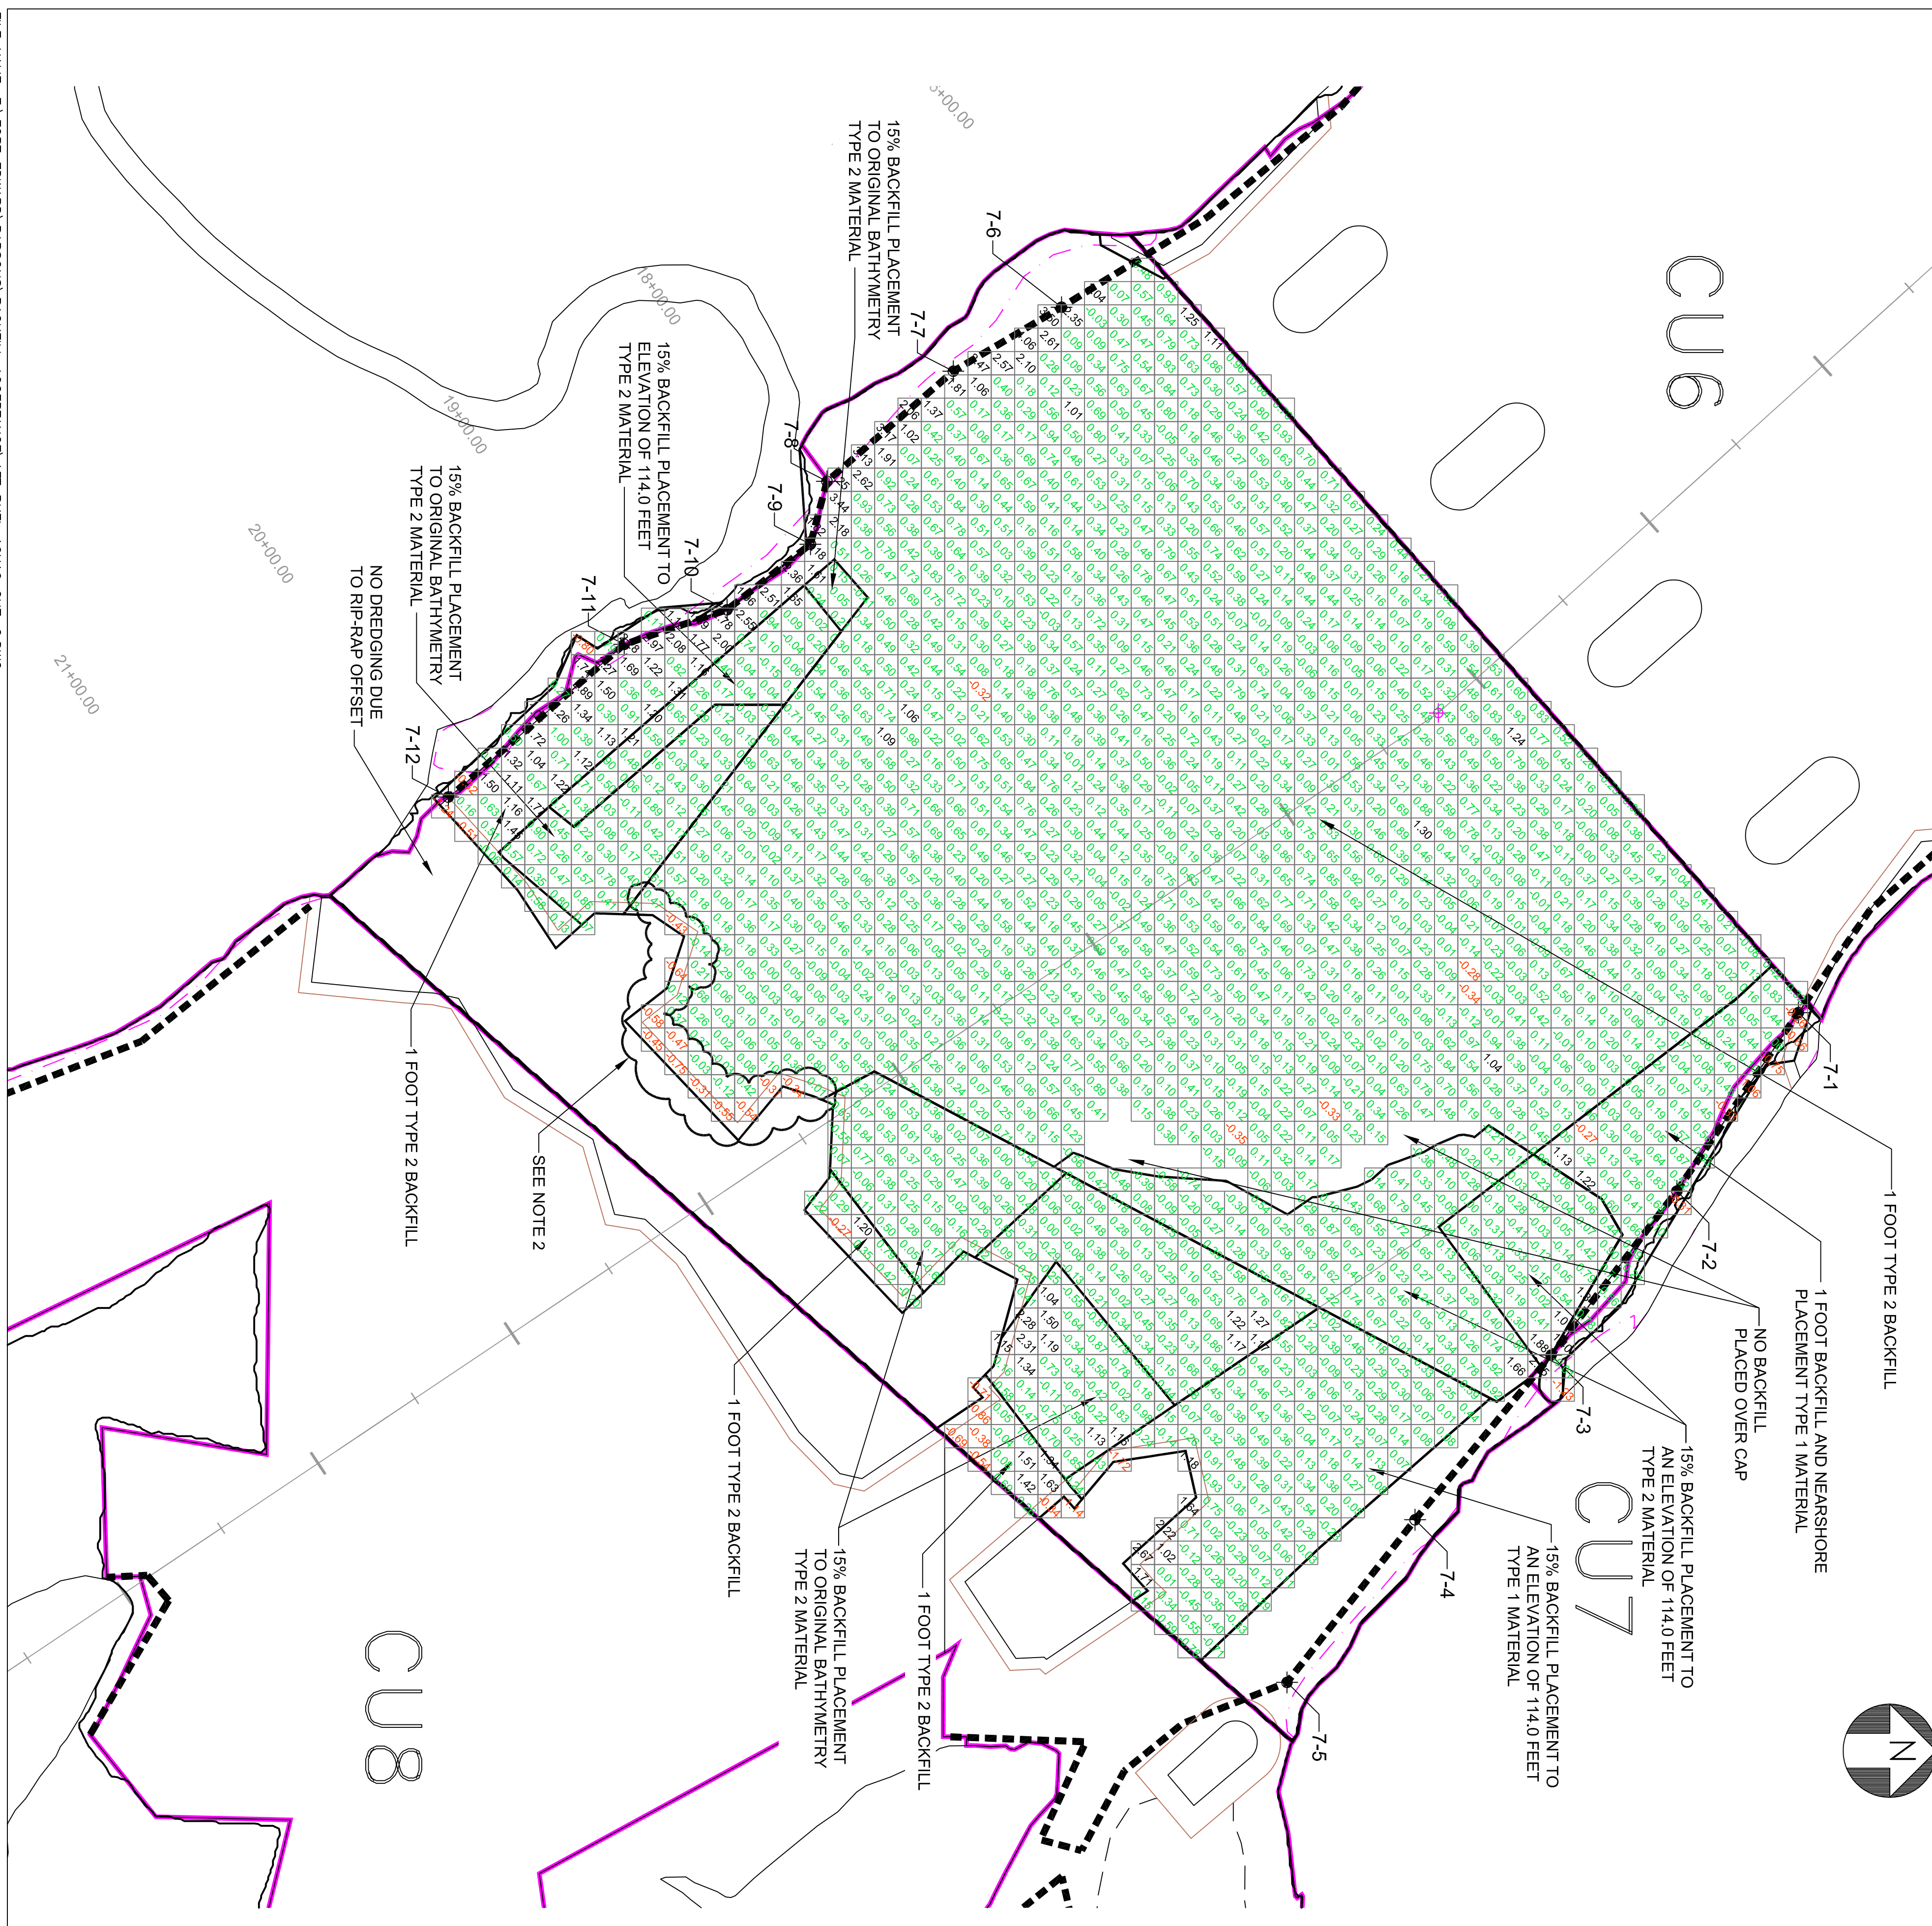

CU-7 Near-Shore Topographic Measurements
 Collected on the 11th of November 2009.

Name	Published Near-Shore Border Set Points		Near-Shore Topographic Measurements		Check	Horz. Dist	Vert. Diff.	
	Easting	Northing	Easting	Northing				
7-1	724,613.43	1,615,795.99	117.50	724,613.73	1,615,796.57	115.89	0.64	-1.61
7-2	724,689.91	1,615,743.93	117.50	724,612.43	1,615,800.02	117.02	0.15	-0.48
7-3	724,760.29	1,615,690.00	117.50	724,690.00	1,615,743.55	117.31	0.39	-0.19
7-4	724,830.83	1,615,631.68	117.50	724,760.24	1,615,690.31	118.08	0.31	0.58
7-5	724,900.51	1,615,576.79	117.50	724,830.83	1,615,631.68	116.99	3.49	-0.51
7-6	724,971.11	1,615,524.51	117.50	724,900.07	1,615,576.26	116.21	0.72	-1.29
7-7	724,338.46	1,615,433.72	117.50	724,971.11	1,615,524.51	117.18	2.33	-0.32
7-8	724,385.69	1,615,379.54	117.50	724,338.46	1,615,433.72	118.05	0.38	0.35
7-9	724,412.60	1,615,327.47	117.50	724,385.69	1,615,379.54	118.64	0.15	1.14
7-10	724,440.72	1,615,336.72	117.50	724,412.60	1,615,327.47	119.19	2.43	1.69
7-11	724,455.54	1,615,292.63	117.50	724,440.72	1,615,336.72	118.23	3.81	0.73
7-12	724,521.22	1,615,217.40	117.50	724,455.54	1,615,292.63	117.66	0.31	0.16

Additional Topographic Measurements provided as part of CU7 from 2 Acceptance Packages:

7-10	724,440.72	1,615,336.72	117.50	724,440.84	1,615,336.78	118.27	0.13	0.77
7-11	724,455.54	1,615,292.63	117.50	724,452.68	1,615,293.65	118.59	0.16	1.09
7-12	724,521.22	1,615,217.40	117.50	724,458.66	1,615,295.25	117.75	4.07	0.25
				724,516.46	1,615,223.67	116.77	7.87	-0.73

NOTES:

- OSI MULTIBEAM SURVEY DATE #1 OCTOBER 28, 2009. OSI MULTIBEAM SURVEY DATE #2 NOVEMBER 8, 2009.
- BASED ON RESULTS OF MULTIBEAM #1, DREDGING CONTRACTOR PLACED ADDITIONAL BACKFILL FROM OCTOBER 30 THROUGH NOVEMBER 7, 2009. DATA IN CLOUDED AREA BASED ON OSI MULTIBEAM SURVEY DATE #2 NOVEMBER 8, 2009
- NUMERIC VALUES IN 10'X10' GRID REPRESENT DIFFERENCE TO TARGET THICKNESS (POSITIVE NUMBERS REFLECT THICKNESS ABOVE TARGET THICKNESS). COLORS DETERMINED USING DIFFERENT BACKFILL TOLERANCES DESCRIBED IN SPEC SECTION 13720.

15% Volume Table

Area	15% Volume (CY)
CU-7 15%	5,694

- Notes:
- Volume calculations are based on data collected through the 9th of November 2009.
 - Volumes were computed using 1'x1' cell center average data sets. In areas where the near-shore prism slope did not extend underneath the 15% backfill areas, additional slopes were added.
 - Volumes were computed using HYPERACK, Inc. 2008 TIN to TIN method.
 - The volume information presented in this table are the results of multibeam surveys performed by Ocean Survey, Inc. on the survey dates indicated and can only be considered representative of the conditions existing during that time.

LEGEND

- 10X10 GRID WITHIN DESIGN GUIDELINES
- 10X10 GRID LESS THAN DESIGN GUIDELINES
- 10X10 GRID ABOVE DESIGN GUIDELINES
- CU BOUNDARY
- CU SUBUNIT BOUNDARY
- NEARSHORE BORDER SET POINT (DATA CONTAINED IN NEARSHORE SUMMARY TABLE)
- POTENTIAL LOCATION FOR RIVERINE FRINGING WETLAND CONSTRUCTION (PLANTING BY OTHERS)
- NEARSHORE BORDER (117.5 FEET)


1 ft. Average Thickness Table

Subunit	Average Thickness (ft)	Approx. Area (acre)	Intended Vol. (CY)	Actual Vol. (CY)	Variation From Planned (CY)
CU7-1	1.24	0.67	1077.8	1356.4	258.7
CU7-2	1.30	0.59	951.9	1235.9	284.0
CU7-3	1.37	0.68	1096.3	1505.4	409.1
CU7-4	1.33	0.63	1018.5	1349.7	331.2
CU7-5	1.14	0.32	511.1	585.9	74.7
Total =					1,357.7

Notes:
 Average thickness and volumes were computed using 10x10 cell center average data sets.

**CU7
 BACKFILL PLACEMENT ACCEPTANCE
 SURVEY**

DATE	11/19/09	APPROVED BY	JHG	DRAWING NO.	CU7-1
DESIGNER	JHG	CHECKED BY	MG	SCALE	AS SHOWN
REV#	DATE	DRN BY			
1	11/19/09	JHG	REVISED PER EPA COMMENTS	MG	
0	11/16/09	JHG	ISSUED FOR EPA REVIEW	MG	
PARSONS			PROJECT OFFICE	CU7	
FORT EDWARD, N.Y. 12828 (518) 746-5311			BACKFILL PLACEMENT ACCEPTANCE SURVEY		

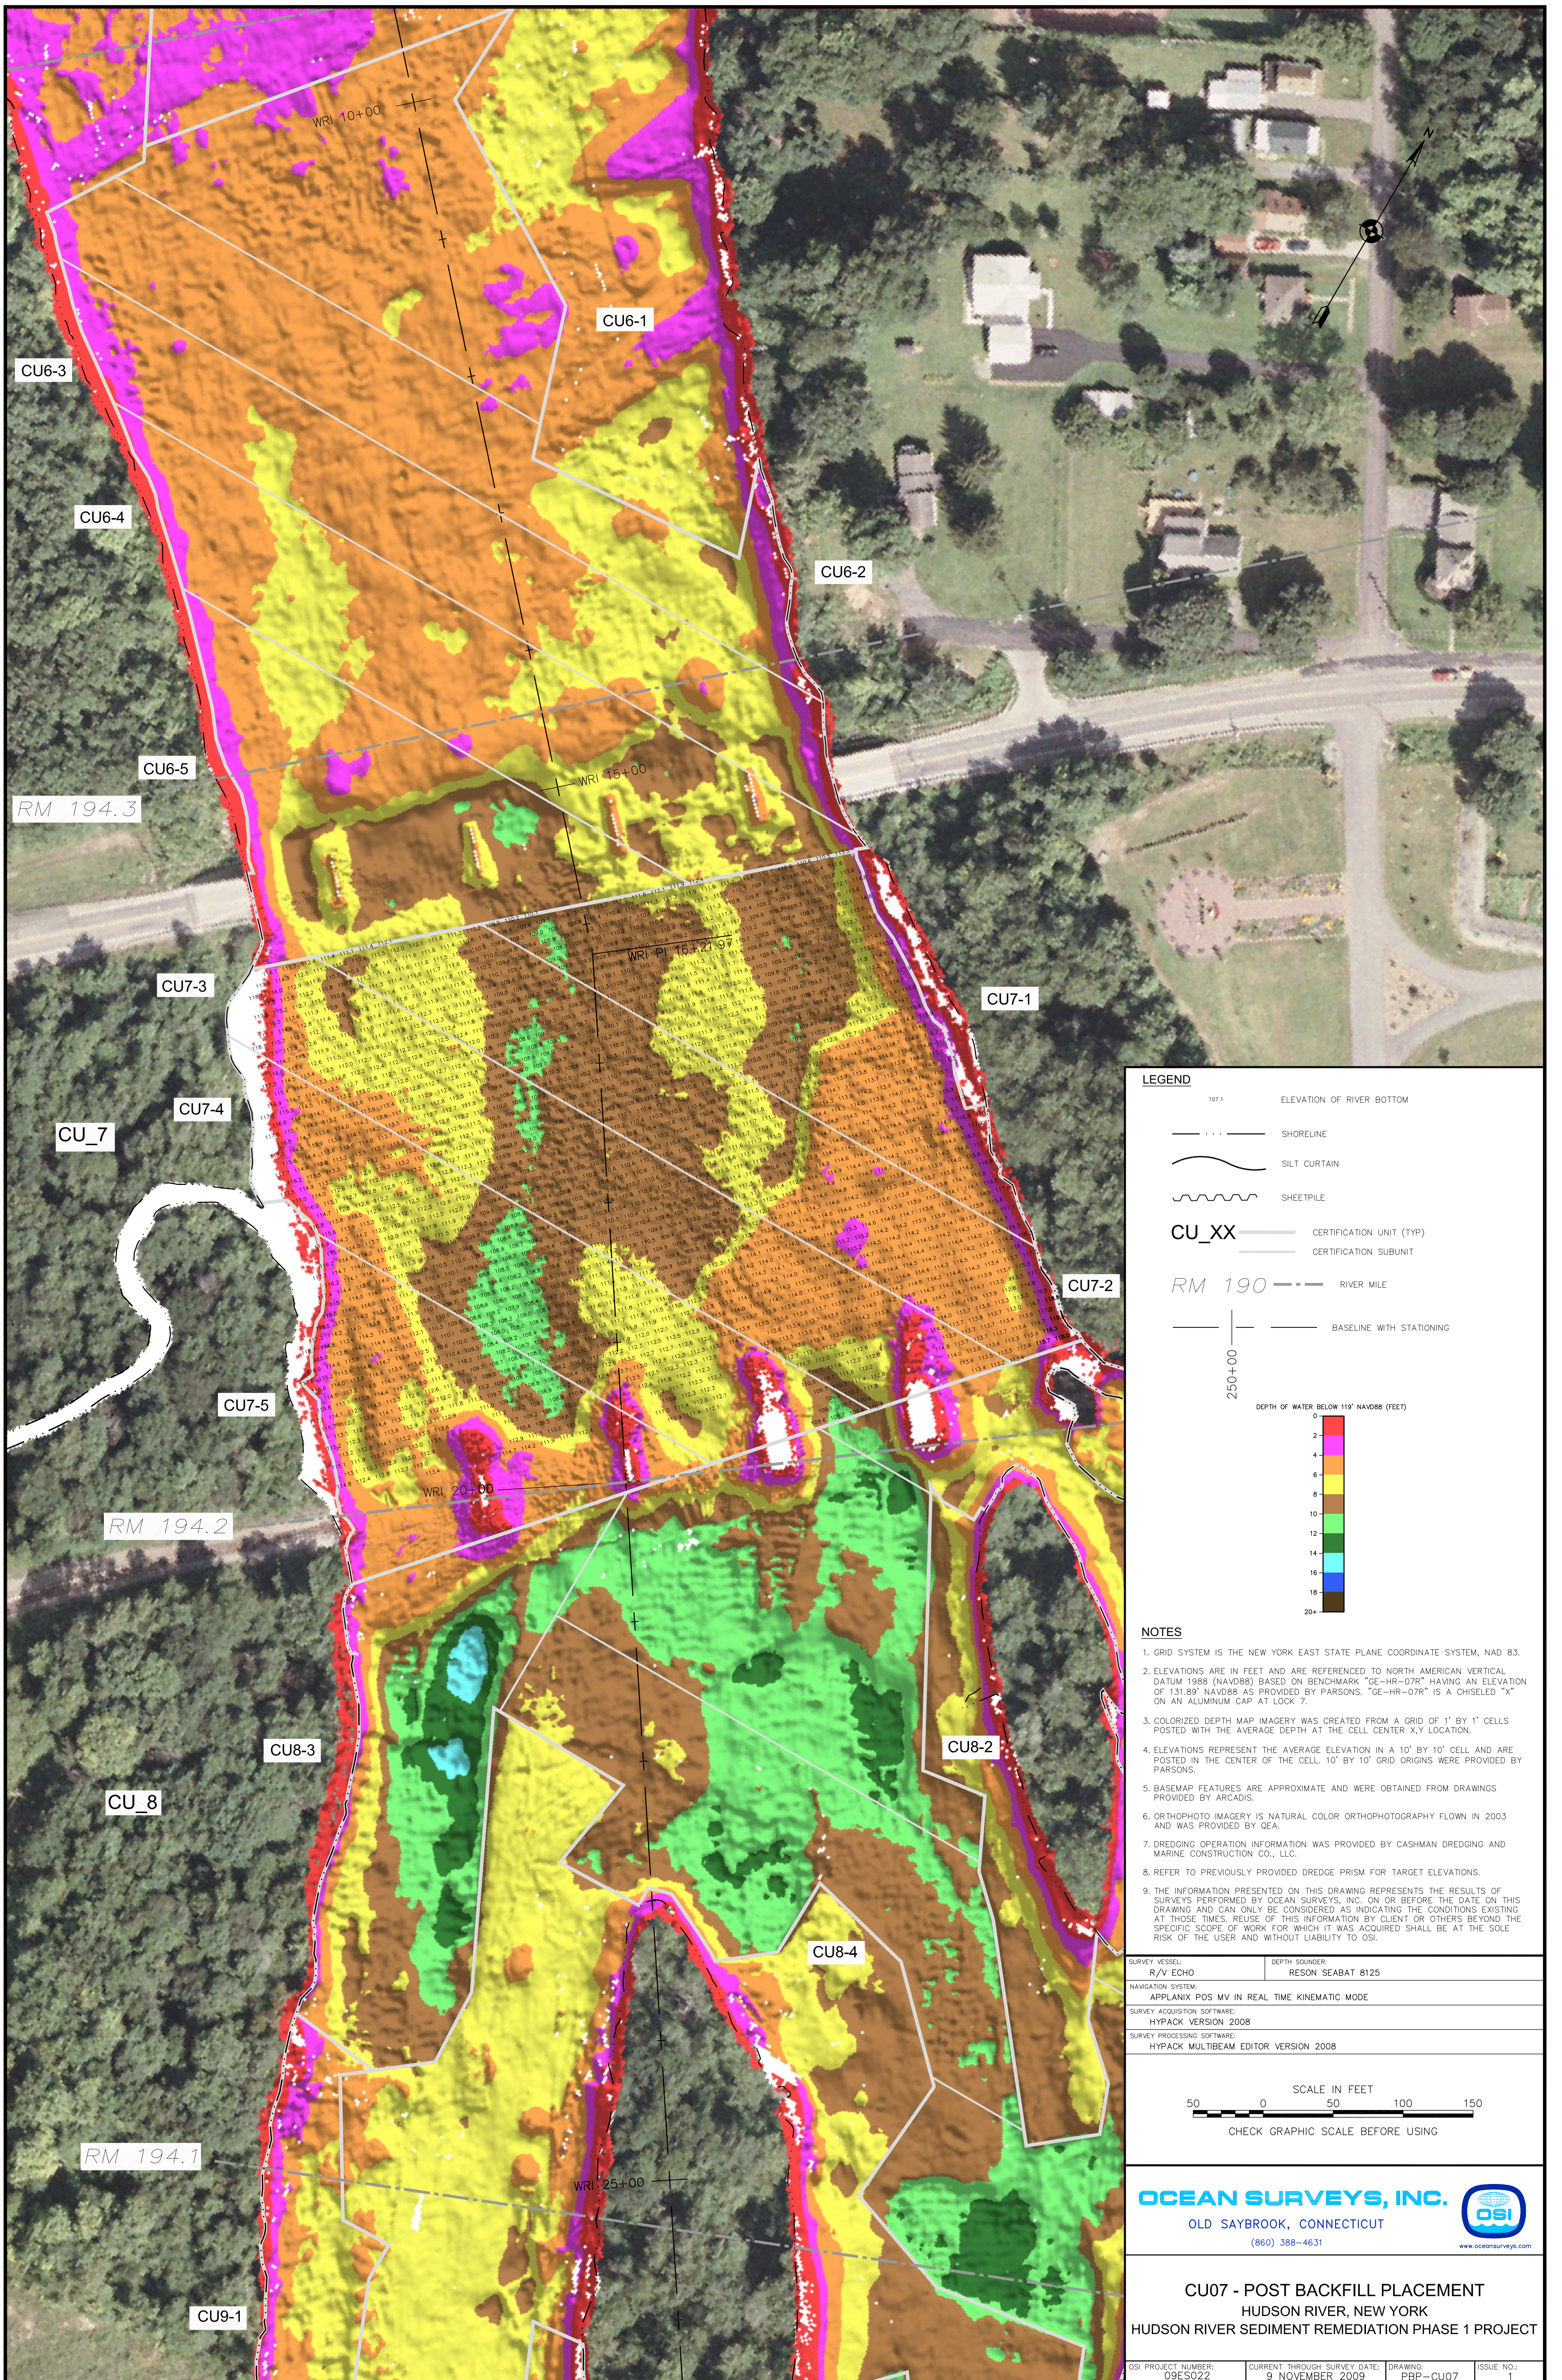

LEGEND

- 107.1 ELEVATION OF RIVER BOTTOM
- · · · — SHORELINE
- — — — SILT CURTAIN
- — — — SHEETPILE
- CU_XX — — — — CERTIFICATION UNIT (TYP)
- — — — CERTIFICATION SUBUNIT
- RM 190 — — — — RIVER MILE
- — — — BASELINE WITH STATIONING


250+00

DEPTH OF WATER BELOW 119' NAVD88 (FEET)

0
2
4
6
8
10
12
14
16
18
20+

- NOTES**
- GRID SYSTEM IS THE NEW YORK EAST STATE PLANE COORDINATE SYSTEM, NAD 83.
 - ELEVATIONS ARE IN FEET AND ARE REFERENCED TO NORTH AMERICAN VERTICAL DATUM 1988 (NAVD88) BASED ON BENCHMARK "GE-HR-07R" HAVING AN ELEVATION OF 131.89' NAVD88 AS PROVIDED BY PARSONS. "GE-HR-07R" IS A CHISELED "X" ON AN ALUMINUM CAP AT LOCK 7.
 - COLORIZED DEPTH MAP IMAGERY WAS CREATED FROM A GRID OF 1' BY 1' CELLS POSTED WITH THE AVERAGE DEPTH AT THE CELL CENTER, X,Y LOCATION.
 - ELEVATIONS REPRESENT THE AVERAGE ELEVATION IN A 10' BY 10' CELL AND ARE POSTED IN THE CENTER OF THE CELL. 10' BY 10' GRID ORIGINS WERE PROVIDED BY PARSONS.
 - BASEMAP FEATURES ARE APPROXIMATE AND WERE OBTAINED FROM DRAWINGS PROVIDED BY ARCADIS.
 - ORTHO PHOTO IMAGERY IS NATURAL COLOR ORTHOPHOTOGRAPHY FLOWN IN 2003 AND WAS PROVIDED BY OEA.
 - DREDGING OPERATION INFORMATION WAS PROVIDED BY CASHMAN DREDGING AND MARINE CONSTRUCTION CO., LLC.
 - REFER TO PREVIOUSLY PROVIDED DREDGE PRISM FOR TARGET ELEVATIONS.
 - THE INFORMATION PRESENTED ON THIS DRAWING REPRESENTS THE RESULTS OF SURVEYS PERFORMED BY OCEAN SURVEYS, INC. ON OR BEFORE THE DATE ON THIS DRAWING AND CAN ONLY BE CONSIDERED AS INDICATING THE CONDITIONS EXISTING AT THOSE TIMES. REUSE OF THIS INFORMATION BY CLIENT OR OTHERS BEYOND THE SPECIFIC SCOPE OF WORK FOR WHICH IT WAS ACQUIRED SHALL BE AT THE SOLE RISK OF THE USER AND WITHOUT LIABILITY TO OSI.

SURVEY VESSEL: R/V ECHO	DEPTH SOUNDER: RESON SEABAT 8125
NAVIGATION SYSTEM: APPLANIX POS MV IN REAL TIME KINEMATIC MODE	
SURVEY ACQUISITION SOFTWARE: HYPACK VERSION 2008	
SURVEY PROCESSING SOFTWARE: HYPACK MULTIBEAM EDITOR VERSION 2008	

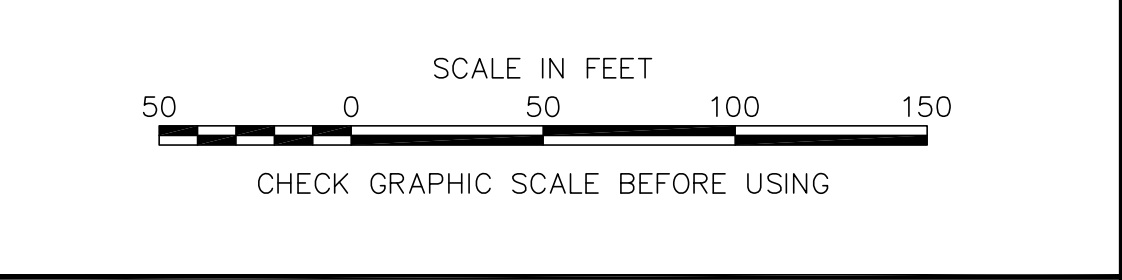


OCEAN SURVEYS, INC. 

OLD SAYBROOK, CONNECTICUT
(860) 388-4631
www.oceansurveys.com

CU07 - POST BACKFILL PLACEMENT
HUDSON RIVER, NEW YORK
HUDSON RIVER SEDIMENT REMEDIATION PHASE 1 PROJECT

OSI PROJECT NUMBER: 09ES022	CURRENT THROUGH SURVEY DATE: 9 NOVEMBER 2009	DRAWING: BFP-CU07	ISSUE NO.: 1
--------------------------------	---	----------------------	-----------------

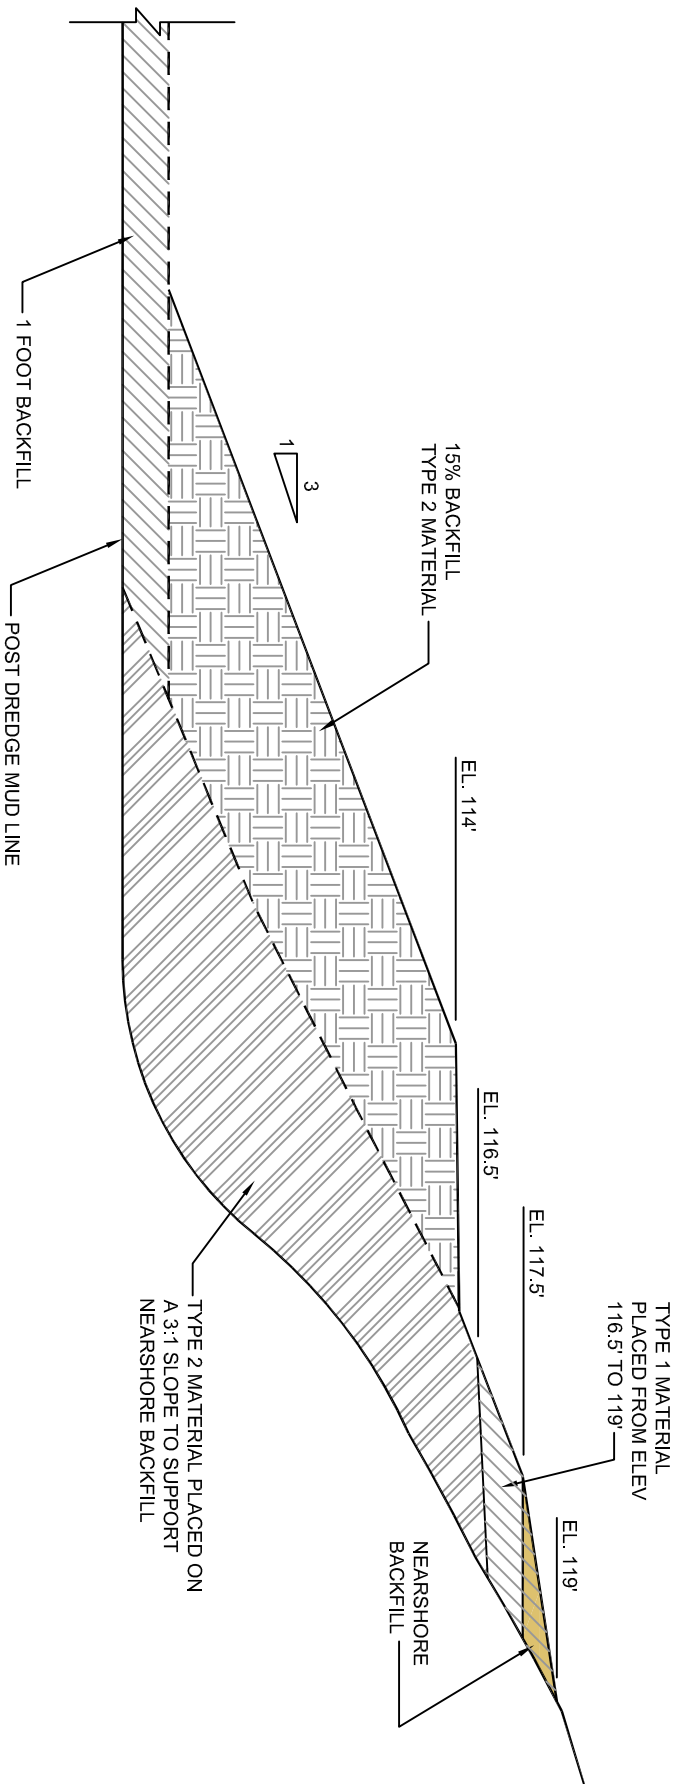

CUT NEAR SHORE BACKFILL WITH 15% BACKFILL TO ELEV 114' PLACEMENT DETAIL

TYPICAL SECTION NOT TO SCALE

**RECORD
DRAWING**

PARSONS <small>COMMERCIAL TECHNOLOGY GROUP</small> GE COMPANY - PARSONS PROJECT OFFICE BUILDING 40-1, 381 BROADWAY FORT EDWARD, N.Y. 12828 (518) 746-5311		DRAWING TITLE CUT NEAR SHORE BACKFILL WITH 15% BACKFILL PLACEMENT DETAIL	
DRAWN BY JHG	CHECKED BY MG	DRAWING NO. CUT-BF-C01	SCALE NOT TO SCALE
DATE 11/15/09	APPROVED BY MG	JOB 442209	

Correspondence
(Letters and Emails)

Galbraith, Michael

From: King.David@epamail.epa.gov
Sent: Saturday, November 14, 2009 9:36 AM
To: Andrew Inglis
Cc: Michael J. Johnson; Timothy Kruppenbacher; Galbraith, Michael; Bryan Minor; Gary Klawinski; Joseph Moloughney
Subject: Re: Discussions regarding CU Backfill and Cap placement

Andrew, I agree with summary.

Dave

Sent by EPA Wireless E-Mail Services

From: "Inglis, Andrew A (GE, Corporate)" [andrew.inglis@ge.com]
Sent: 11/13/2009 05:13 PM EST
To: David King
Cc: <MJohnson@louisberger.com>; "Kruppenbacher, Timothy A (GE, Corporate)" <timothy.kruppenbacher@ge.com>; <michael.galbraith@parsons.com>; <USACE_HRFO@roadrunner.com>; <GKlawinski@ene.com>; "Joseph Moloughney" <Joseph_Moloughney@canals.state.ny.us>
Subject: Discussions regarding CU Backfill and Cap placement

Dave,

Today and yesterday we met and reviewed progress surveys of cap and backfill placement in CUs 1, 2, 3, 4, 7 and 18. This email confirms decisions made during the meeting based on reviews of the maps presented during the meeting.

CU1.

In CU1 it was agreed that sufficient thickness of isolation layer material has been placed while providing enough room to place armor stone below the 105.2' elevation in the navigation channel. It was agreed that placement of armor stone can begin.

CU2.

In CU2 it was agreed that the top of cap and backfill elevations were acceptable. GE will prepare a Form 2 package for EPA review.

CU3 .

In CU3 it was agreed that the top of cap and backfill elevations were acceptable, it was discussed that GE was in the process of placing backfill in an area of the navigation channel where the post dredge elevations were below 102' elevation. Once GE has surveyed that additional backfill location GE will prepare a Form 2 package for EPA review.

CU4.

In CU4 it was agreed that the top of cap elevations in the north east quarter of the CU was acceptable and that backfill placement in that area may begin.

CU7.

In CU7 it was agreed that the top of cap and backfill elevations were acceptable. GE will prepare a Form 2 package for EPA review.

CU18

In CU18 it was agreed that the top of cap elevations were acceptable in both of the cap locations in that CU.

Please let me know if I missed anything.

Thanks,

Andrew A. Inglis
Dredging Task Leader
GE

T +1 518-746-5256

381 Broadway
Building 40-2
Fort Edward, NY 12828
GE Corporate Environmental Programs

GE Imagination at Work

CU-08

Form 2

CU Certification of Completion

CU BACKFILL/ENGINEERED CAP COMPLETION APPROVAL - FORM 2						
Reporting Date	12/4/2009				Placement Start Date	10/22/2009
CU Number	8				Placement End Date	12/4/2009
Approximate CU Centroid	Northing	1615205	Easting	734925	NY State NAD 83	
CU Size	4.99	Acres				
Backfill Area	3.51	Acres				
Cap Area	1.48	Acres				
Backfill Surface Mean Tri+ PCBs Concentration (when required)		NA		mg/kg		
Number of nodes sampled		NA		mg/kg		
Backfill	Type of Backfill	Reference to appropriate drawings attached to Approval Form 1				
X	Type 1, Type 2, Type 3, 15%, Nearshore	CU8 Backfill and Cap Plan, 10/29/09				
Cap	Type of Cap	Reference to appropriate drawings attached to Approval Form 1				
X	Type "B" Medium Velocity Cap Type "B" Low Velocity Cap	CU8 Backfill and Cap Plan, 10/29/09				
CU Checklist		Indicate one of the following			Reviewer Initial Acceptance	
Item	Attached	Not Applicable	GE	EPA		
Drawing of Installed Backfill/Cap (with record details, thickness and sample locations [when backfill/cap are placed])	x					
Where applicable in backfill areas provide the following: Sample locations (coordinates), depths, Aroclor and Tri+ PCB concentrations collected including analytical data, field observations, (hard copy and electronic copies [in database format or equivalent])		x				
Comments						
Refer to CU8 Narrative Summary of Backfill and Capping and CU8 Backfill Placement Drawings.						
Upon signing this document, GE certifies that the backfill/cap has been installed satisfactorily and that no further backfill placement or capping is required for this CU. These remedial activities exclude long term operation, monitoring, maintenance and adaptive management at the CU. EPA accepts this certification.						
Signature of GE Representative			Signature of EPA Representative			
Signature _____			Signature _____			
Name _____			Name _____			
Date _____			Date _____			

Narrative

CU 8

Narrative Summary of Backfill and Capping and EPA Backfill and Capping Agreements

1.0 Cap Placement

Type "B" Medium Velocity and Type "B" Low Velocity Caps were placed in accordance with the CU 8 Backfill and Cap Plan drawing, dated October 29, 2009, which was provided to EPA as part of the CU 8 Form 1 package. Final multi-beam bathymetric survey of the Type "B" Low Velocity Cap was performed on November 14, 2009, as shown on the attached CU 8 Type "B" Low Velocity Cap Acceptance Survey map, dated December 2, 2009. The surveyed cap thickness on a 5' x 5' grid is shown for the Type "B" Low Velocity Cap. Final multi-beam bathymetric surveys of the Type "B" Medium Velocity isolation layers were performed on November 12 and 15, 2009, as shown on the attached CU 8 Type "B" Medium Velocity Cap Isolation Layer Acceptance Survey map, dated December 2, 2009. As noted on the referenced drawing, the reported thickness of the isolation layer in the northern Type "B" Medium Velocity Cap includes some amount of Type 2 backfill placed in this area prior to the designation of this area as requiring a cap. After the partial placement of Type 2 backfill in some of this area, a full 9-inch layer of Type 2 material with TOC, in accordance with the design requirements for a Type "B" Medium velocity cap, was placed above the Type 2 backfill material. The surveyed isolation layer thickness on a 10' x 10' grid is shown for the Medium Velocity isolation layers. A multi-beam survey of the armor stone layer of the Type "B" Medium Velocity cap areas was completed on November 18, 2009, as shown on the attached CU 8 Type "B" Medium Velocity Cap Armor Layer Acceptance Survey map, dated December 2, 2009. The surveyed armor layer thickness on a 5' x 5' grid is shown for the Medium Velocity Type "B" cap areas.


2.0 Backfill Placement

In accordance with the CU8 Backfill and Cap Plan Drawing, dated October 29, 2009, which was provided to EPA as part of the CU 8 Form 1 package, 1-foot Backfill, Nearshore Backfill and 15% Additional Backfill were placed in CU 8. Final multi-beam bathymetric surveys of the backfill materials were performed on November 10 and 19, 2009 as shown on the attached CU 8 Backfill Acceptance Survey map, dated November 24, 2009. The difference to target thickness of the final backfill surface is shown on a 10' x 10' grid for the 1-foot Backfill and the 15% Additional Backfill. For Nearshore Backfill, the elevations of the nearshore set points are provided in the table on the attached CU 8 Backfill Acceptance Survey map, dated December 3, 2009.

3.0 EPA Field Agreements Specific to CU 8 Backfill and Capping

1. During the 4:00 PM meeting with EPA on October 12, 2009, EPA agreed that acceptance surveys of partial areas of a CU may be performed and used for acceptance once placement of backfill or cap in those areas is complete.
2. During the 4:00 PM meeting with EPA on October 20, 2009, GE and EPA agreed to create a wetland to replace riverine fringing wetland (RFW) removed from CU7. This RFW was situated in CU8 adjacent to the Roger's Island shoreline just south of the railroad bridge.
3. During the 4:00 PM meeting with EPA on October 27, 2009, GE presented a Draft Backfill and Cap Plan to EPA, showing an area of approximately 75 ft² as receiving a Type "B" high velocity cap. Based on the small area, EPA agreed area be modified to a Type "B" medium velocity cap (See Backfill & Cap Record Drawing, dated December 2, 2009).
4. During a 3:00 PM meeting with EPA on November 19, 2009, GE presented a Backfill Acceptance Survey drawing on a 10' x 10' grid in CU 8. EPA agreed that the backfill thicknesses, as shown, were acceptable. The CU8 Backfill Acceptance Survey Drawing, dated November 24, 2009 is included in this package.
5. In an email dated November 25, 2009 GE informed EPA that significant run-out of placed nearshore backfill was being experienced in CU8. To mitigate this situation GE requested approval to fill deeper areas with Type N stone then place Type 1 or Type 2 (as required in the design) on top of the Type N material. EPA approved this request on November 27, 2009 (see attached email dated November 27, 2009).

Figures

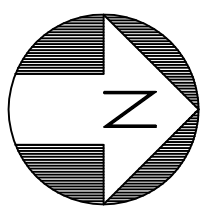


MULTIBEAM
SOUNDINGS
NOT AVAILABLE
DUE TO
SHALLOW DEPTH

FORMER SANDBAR

TYPE B
LOW VELOCITY CAP

UNNAMED ISLAND

MATCHLINE


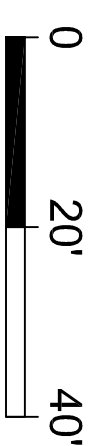


LEGEND

- 0.80 5X5' GRID WITHIN DESIGN GUIDELINES
- 0.25 5X5' GRID LESS THAN DESIGN GUIDELINES
- 0.00 5X5' GRID ABOVE DESIGN GUIDELINES
- BUCKET REFUSAL ENCOUNTERED VIA DREDGING
- CU BOUNDARY
- NEARSHORE BORDER (117.5 FEET)
- MUD - RIP RAP INTERFACE
- 5 FOOT INTERFACE OFFSET
- POTENTIAL LOCATION FOR RIVERINE FRINGING WETLAND CONSTRUCTION (PLANTING BY OTHERS)

MATCHLINE


TYPE B
LOW VELOCITY CAP

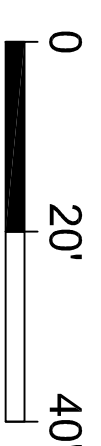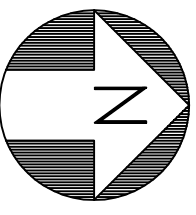

NOTES:

1. OSI MULTIBEAM SURVEY ON NOVEMBER 14, 2009.
2. THICKNESS OF TYPE "B" LOW VELOCITY CAP IS LISTED IN 5X5' GRIDS.


PARSONS		DRAWING TITLE	
GEORGETOWN, DELAWARE PARSONS PROJECT OFFICE BUILDING 40-1, 381 BROADWAY FORT EDWARD, N.Y. 12828 (518) 746-5311		CUB TYPE "B" LOW VELOCITY CAP ACCEPTANCE SURVEY	
DRAWN BY: JHG	CHECKED BY: JHG	DRAWING NO: CUB-1	SCALE: AS SHOWN
DATE: 12/02/09	APPROVED BY: JHG	JOB: 442209.01-01	

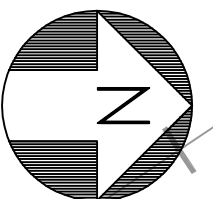

CUR7

CUR8

FORMER SANDBAR

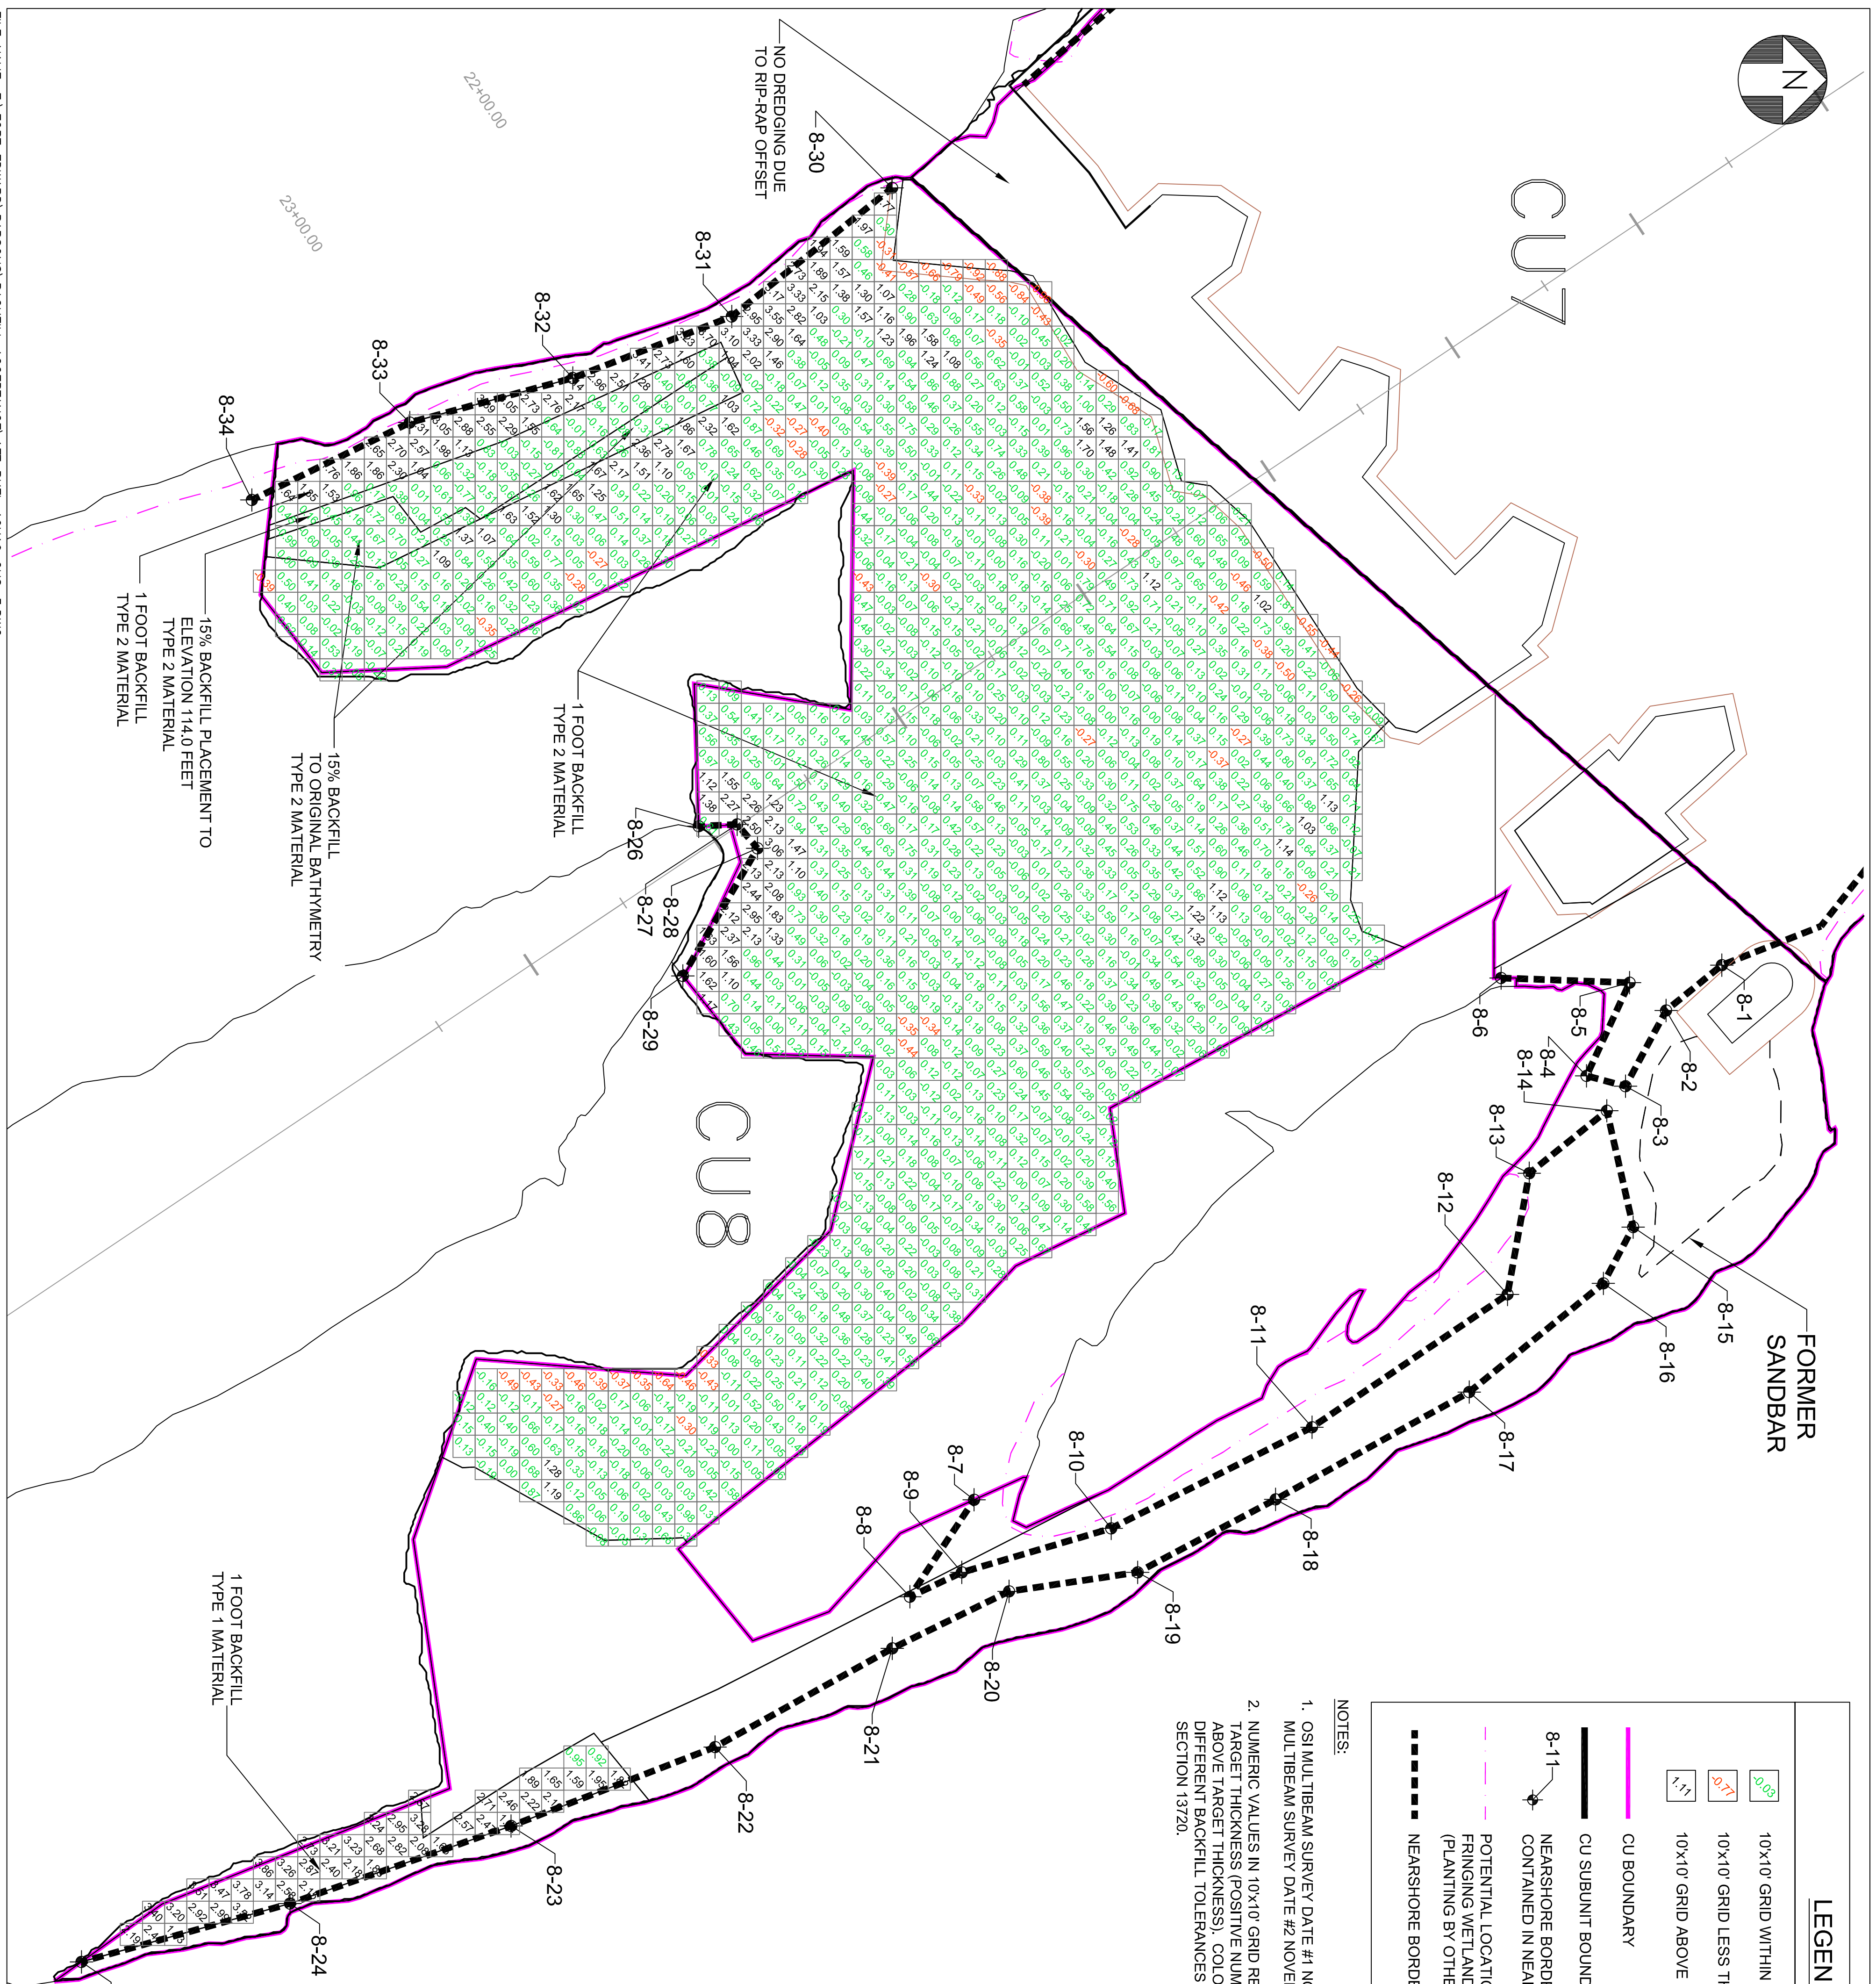

LEGEND

- 10x10' GRID WITHIN DESIGN GUIDELINES
- 10x10' GRID LESS THAN DESIGN GUIDELINES
- 10x10' GRID ABOVE DESIGN GUIDELINES
- CU BOUNDARY
- CU SUBUNIT BOUNDARY
- NEARSHORE BORDER SET POINT (DATA CONTAINED IN NEARSHORE SUMMARY TABLE)
- POTENTIAL LOCATION FOR RIVERINE FRINGING WETLAND CONSTRUCTION (PLANTING BY OTHERS)
- NEARSHORE BORDER (117.5 FEET)

NOTES:
1. OSI MULTIBEAM SURVEY DATE #1 NOVEMBER 10, 2009. OSI MULTIBEAM SURVEY DATE #2 NOVEMBER 19, 2009.

2. NUMERIC VALUES IN 10x10' GRID REPRESENT DIFFERENCE TO TARGET THICKNESS (POSITIVE NUMBERS REFLECT THICKNESS ABOVE TARGET THICKNESS), COLORS DETERMINED USING DIFFERENT BACKFILL TOLERANCES DESCRIBED IN SPECIFICATION SECTION 13720.

CU-08 Near-Shore Topographic Soundings Collected 2009-11-24, 2009-12-01 and 2009-12-04.


Published Near-Shore Locations			Near-Shore Confirmation			Vert
Name	Easting	Northing	Target Elevation	Check Elevation	Dist	Diff.
8-1	734918.10	161552.13	117.50	734917.83	161552.30	0.17
8-2	734938.53	161597.00	117.50	734938.49	161550.14	0.14
8-3	734972.67	1615488.70	117.50	734972.75	1615488.70	0.08
8-4	734967.99	1615472.13	117.50	734967.77	1615470.84	0.37
8-5	734926.00	1615490.51	117.50	734926.20	1615490.48	0.20
8-6	734923.88	1615432.58	117.50	734923.19	1615433.69	0.45
8-7	735159.08	1615194.98	117.50	735159.48	1615195.02	0.20
8-8	735203.82	1615166.00	117.50	735203.08	1615168.18	0.31
8-9	735191.81	1615189.46	117.50	735191.94	1615189.29	0.17
8-10	735171.98	1615256.80	117.50	735172.06	1615257.14	0.35
8-11	735126.40	1615347.33	117.50	735126.41	1615346.99	0.34
8-12	735066.50	1615435.50	117.50	735066.19	1615435.48	0.31
8-13	735011.90	1615445.31	117.50	735012.00	1615445.37	0.12
8-14	734983.74	1615480.29	117.50	734983.72	1615480.09	0.20
8-15	735036.16	1615492.16	117.50	735036.21	1615492.30	0.09
8-16	735061.56	1615478.70	117.50	735061.26	1615478.37	0.44
8-17	735110.52	1615418.24	117.50	735110.63	1615418.47	0.25
8-18	735158.90	1615391.94	117.50	735158.74	1615391.24	0.21
8-19	735191.80	1615268.73	117.50	735191.60	1615268.90	0.26
8-20	735200.38	1615210.72	117.50	735200.24	1615210.79	0.16
8-21	735226.07	1615158.07	117.50	735226.33	1615158.29	0.34
8-22	735270.55	1615078.19	117.50	735270.26	1615078.48	0.41
8-23	735306.14	1614986.21	117.50	735305.80	1614986.52	0.45
8-24	735341.08	1614886.51	117.50	735340.89	1614886.93	0.46
8-25	735367.40	1614792.49	117.50	735367.70	1614792.34	0.33
8-26	734855.47	1615070.79	117.50	734855.62	1615070.58	0.26
8-27	734854.65	1615088.15	117.50	734854.46	1615087.79	0.40
8-28	734865.43	1615097.34	117.50	734865.52	1615097.35	0.08
8-29	734922.95	1615063.65	117.50	734923.19	1615063.82	0.30
8-30	734567.71	1615158.00	117.50	734567.89	1615158.00	0.17
8-31	734625.69	1615085.69	117.50	734626.04	1615085.62	0.36
8-32	734653.44	1615014.00	117.50	734653.17	1615014.12	0.29
8-33	734673.52	1614940.53	117.50	734673.25	1614940.44	0.08

CU8 15% Backfill Volume Table

Area	15% Volume Placed
CU8 15% BACKFILL	724 CY

- Notes:
- Volume calculations are based on data collected during the 10th of November 2009 survey.
 - Volumes were computed using a 1' x 1' cell center-average data sets.
 - Volumes were computed using HYPACK, Inc. 2008 TIN to TIN.
 - The volume information presented in this table are the results of multibeam surveys performed by Ocean Surveys, Inc. on the survey dates indicated and can only be considered representative of the conditions existing during that time.

CU8 BACKFILL ACCEPTANCE SURVEY

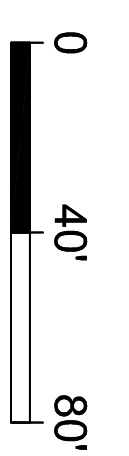

Subunit	Average Thickness (ft)	Approx. Area (acres)	Intended Vol. Placed (CV)	Actual Vol. Placed (CV)	Variation From Planned (CV)
CU 8.2	1.26	0.88	1422.2	1798.1	375.9
CU 8.3	1.15	0.88	1425.9	1643.7	217.8
CU 8.4	1.11	1.07	1733.3	1929.3	196.0
CU 8.5	1.08	0.27	433.3	489.2	35.9

Notes:
Average thickness and volumes were computed using 10x10 cell center-average data sets.

DATE: 12/02/09

REV: 0 DATE: 12/02/09

DRN BY: JHG

ISSUED FOR EPA REVIEW

DRAWING DESCRIPTION: DRAWING DESCRIPTION

DRAWING TITLE: CU8 BACKFILL ACCEPTANCE SURVEY

SCALE: AS SHOWN

DATE: 12/02/09

APPROVED BY: JHG

CHECKED BY: JHG

DRAWING NO: CU8-2

SCALE: AS SHOWN


DATE: 12/02/09

APPROVED BY: JHG

CHECKED BY: JHG

DRAWING NO: CU8-2

SCALE: AS SHOWN

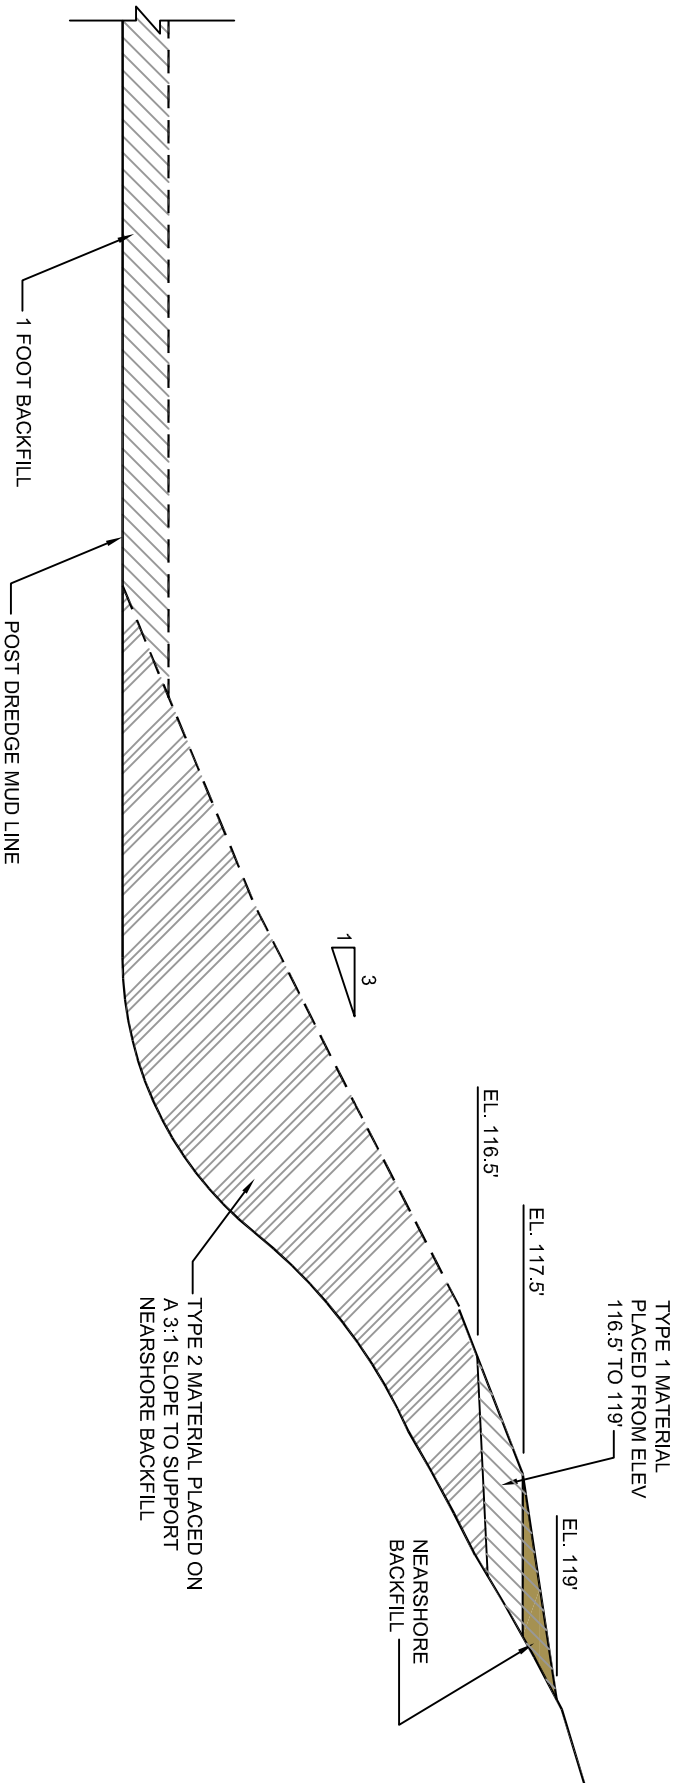


NEAR SHORE BACKFILL PLACEMENT DETAIL

TYPICAL SECTION NOT TO SCALE

RECORD
DRAWING

PARSONS <small>COMMERCIAL TECHNOLOGY GROUP</small>		DRAWING TITLE CU8 NEAR SHORE BACKFILL PLACEMENT DETAIL	
GE COMPANY - PARSONS PROJECT OFFICE BUILDING 40-1, 381 BROADWAY FORT EDWARD, N.Y. 12828 (518) 746-5311		DRAWING NO. C08-BF-C01	
DRAWN BY JHG	CHECKED BY MG	SCALE NOT TO SCALE	JOB 442209
DATE 12/03/09	APPROVED BY MG		


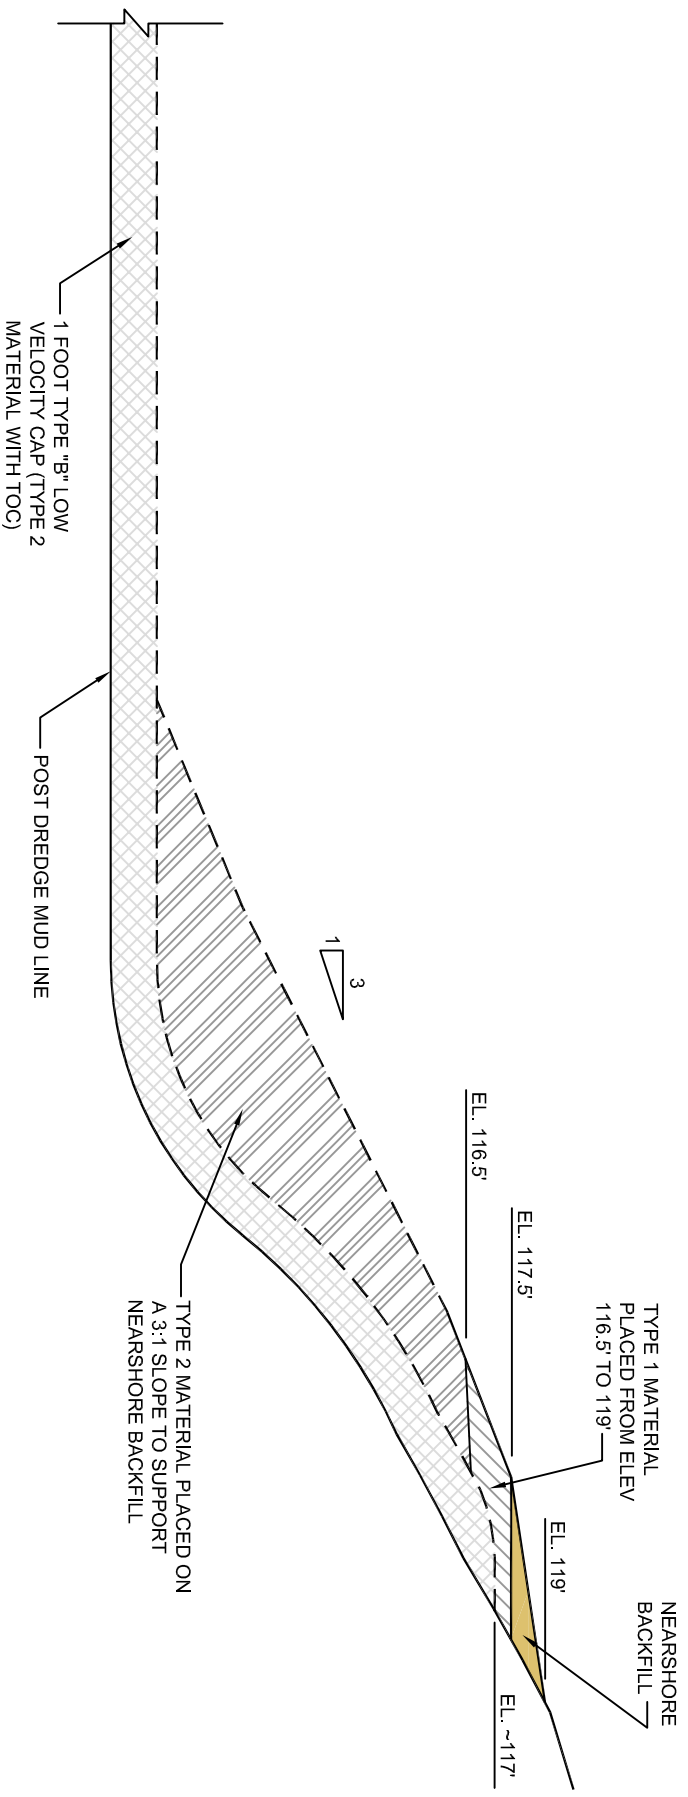


**CU8 - EAST CHANNEL NEAR SHORE BACKFILL
PLACEMENT DETAIL**



TYPICAL SECTION NOT TO SCALE

**RECORD
DRAWING**

		DRAWING TITLE CU8 - EAST CHANNEL NEAR SHORE BACKFILL PLACEMENT DETAIL	
COMMERCIAL TECHNOLOGY GROUP GE COMPANY - PARSONS PROJECT OFFICE BUILDING 40-1, 381 BROADWAY FORT EDWARD, N.Y. 12828 (518) 746-5311		DRAWING NO. CU8-BF-C02	
DRAWN BY JHG	CHECKED BY MG	SCALE NOT TO SCALE	JOB 442209
DATE 12/03/09	APPROVED BY MG		

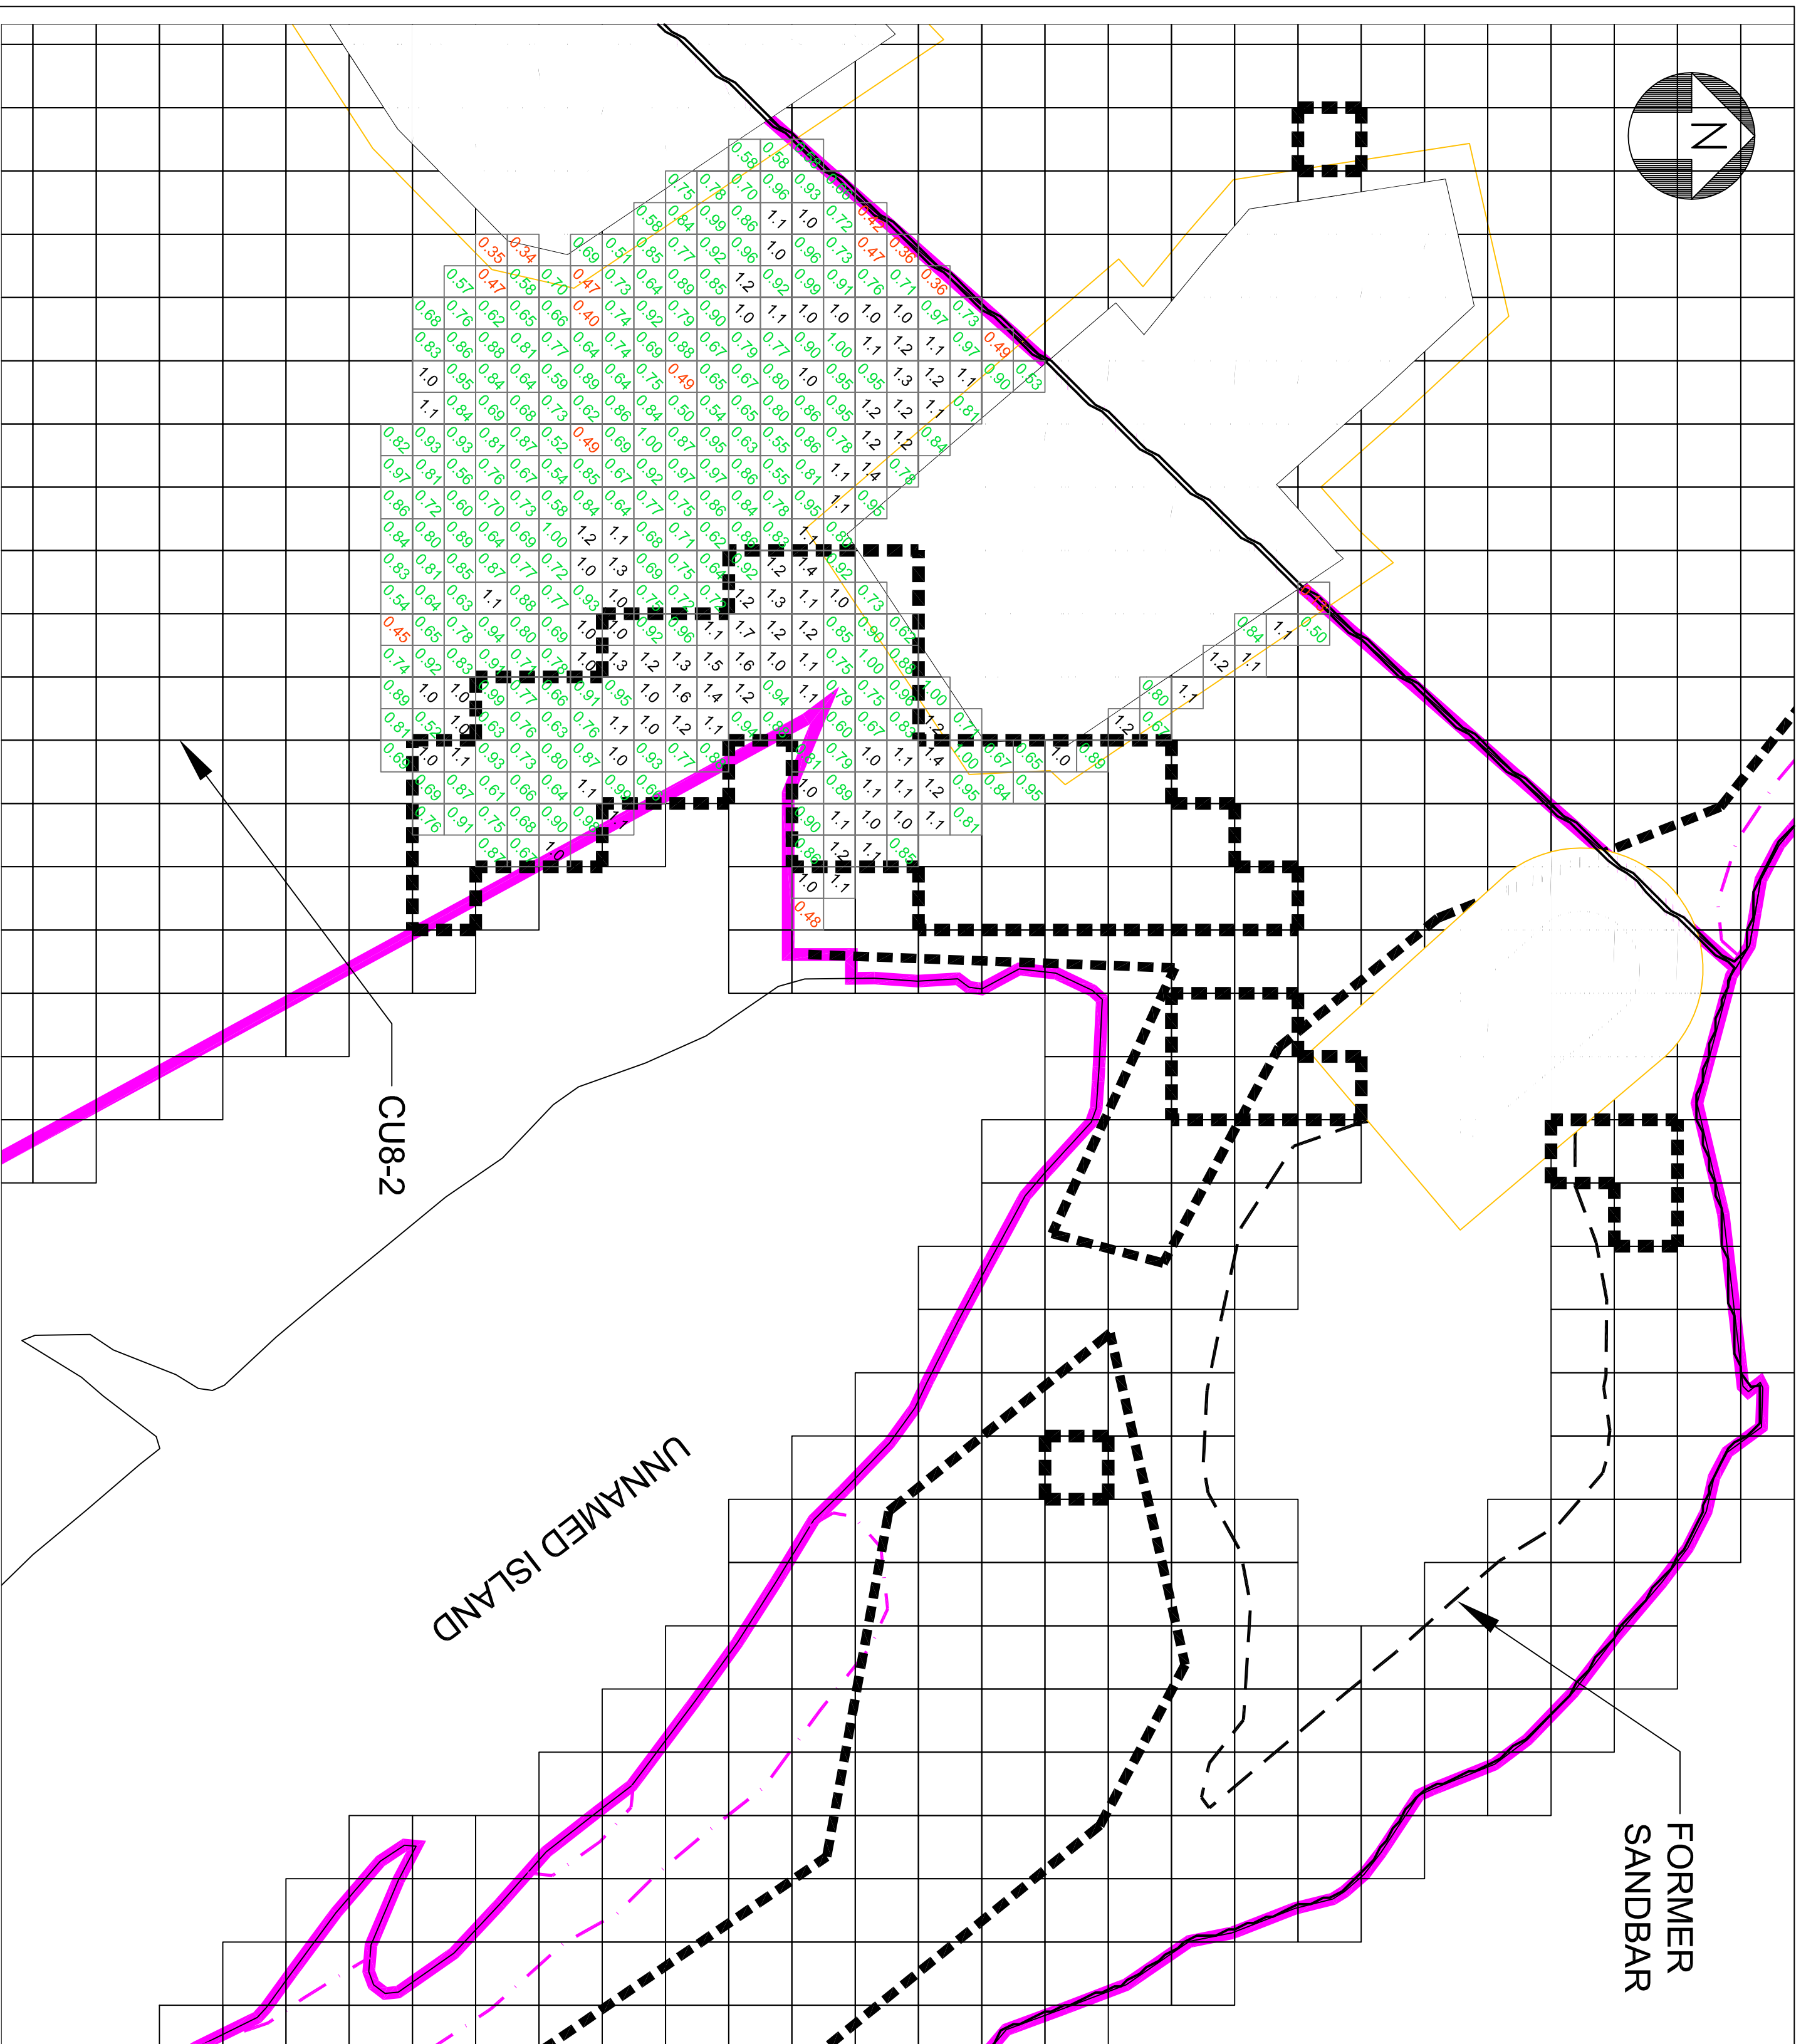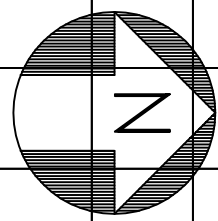

CU8 TYPE "B" MEDIUM VELOCITY CAP
TYPE "N" ARMOR LAYER THICKNESS
NORTHWEST PORTION

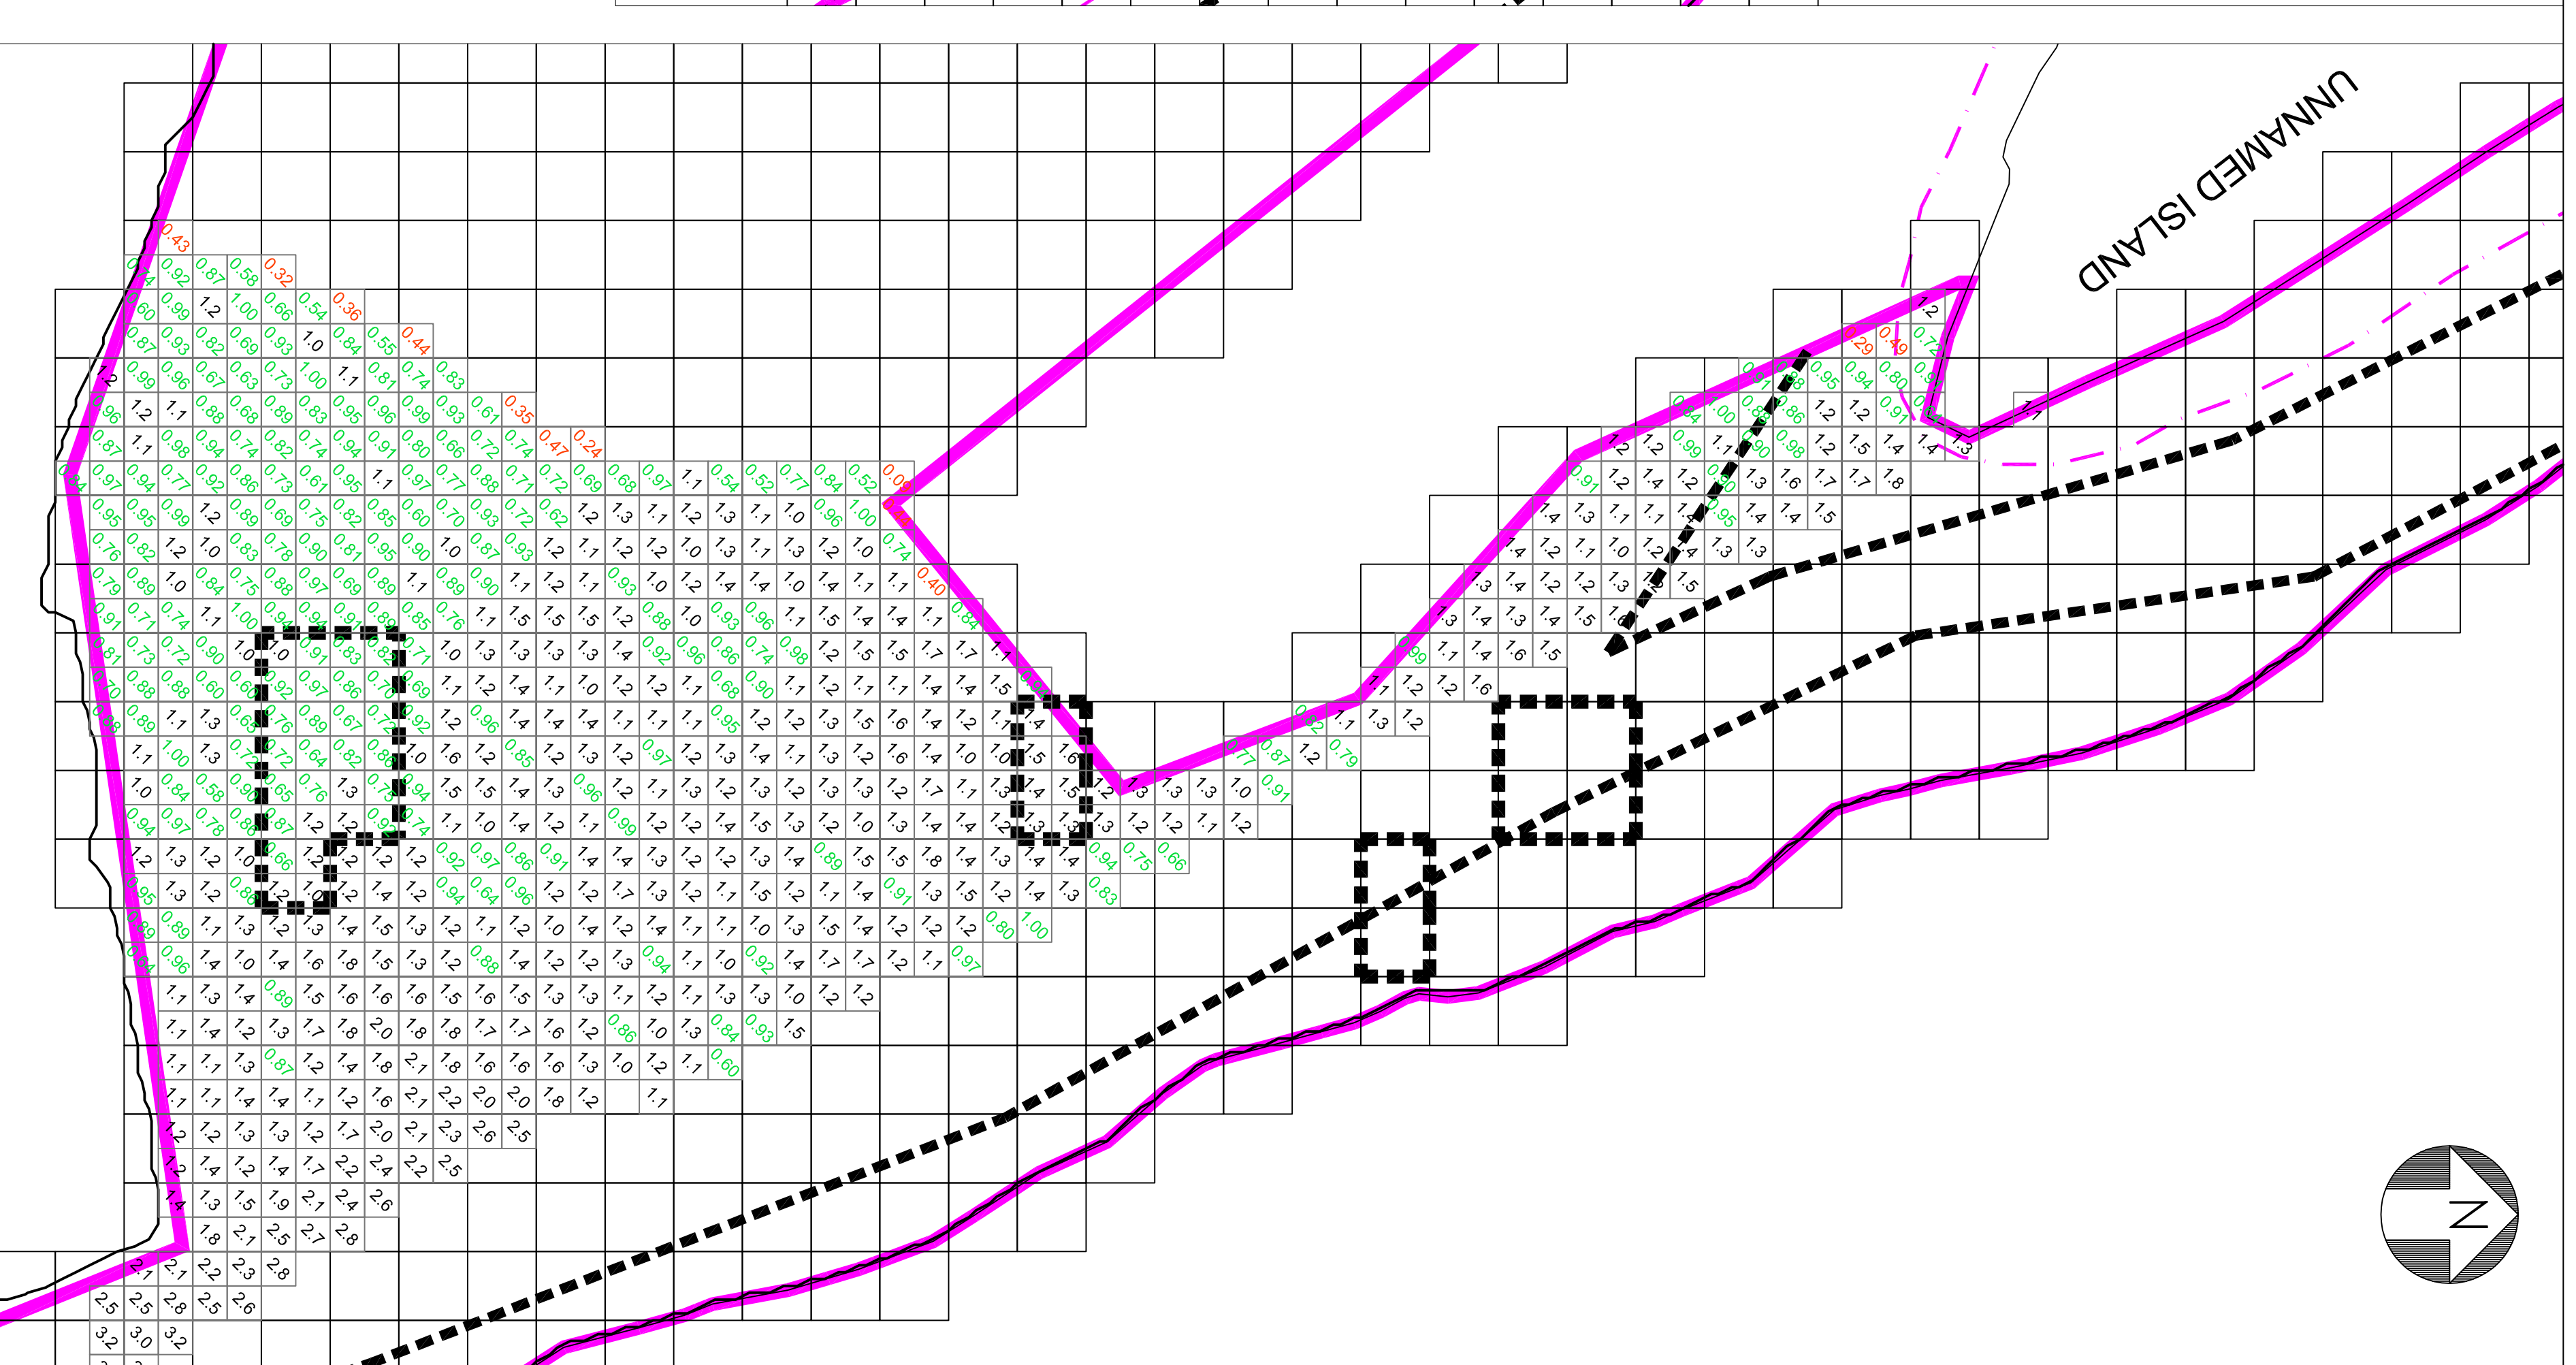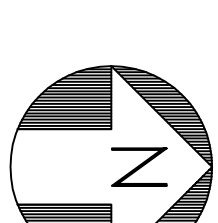


CU8 TYPE "B" MEDIUM VELOCITY CAP
TYPE "N" ARMOR LAYER THICKNESS
SOUTHEAST PORTION

LEGEND

- 0.99 5x5' GRID WITHIN DESIGN GUIDELINES
- 0.49 5x5' GRID LESS THAN DESIGN GUIDELINES
- 1.1 5x5' GRID ABOVE DESIGN GUIDELINES
- BUCKET REFUSAL ENCOUNTERED VIA DREDGING
- CU BOUNDARY
- NEARSHORE BORDER (117.5 FEET)
- MUD - RIP RAP INTERFACE
- 5 FOOT INTERFACE OFFSET
- POTENTIAL LOCATION FOR RIVERINE FRINGING WETLAND CONSTRUCTION (PLANTING BY OTHERS)

NOTES:



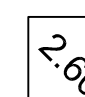
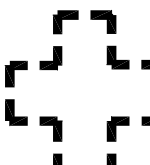


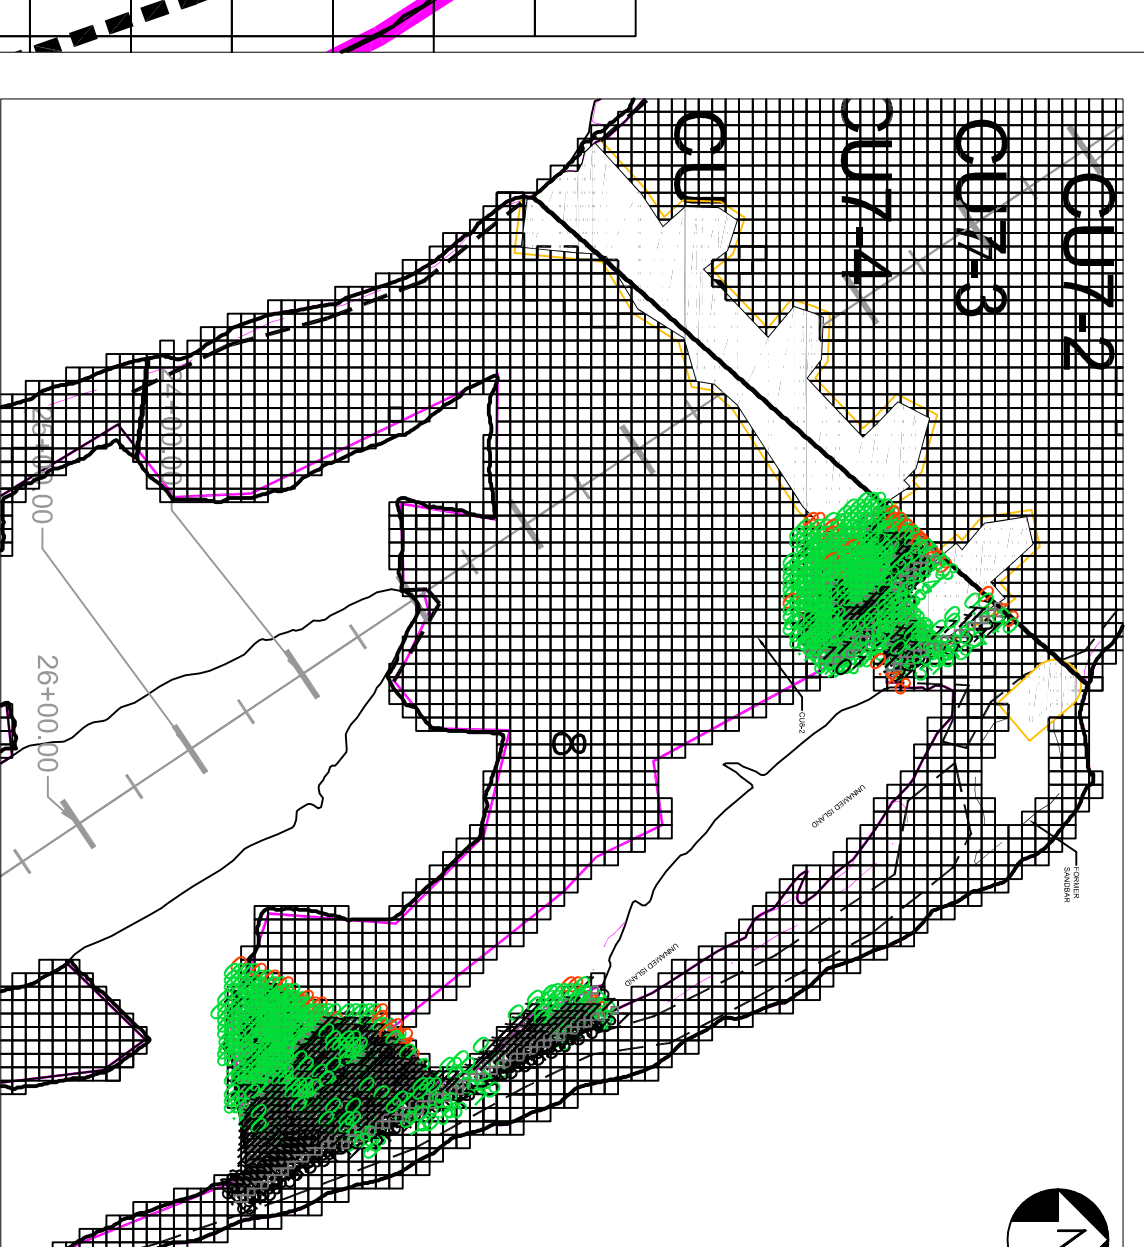


1. OSI MULTIBEAM SURVEY ON NOVEMBER 18, 2009.
2. THICKNESS OF ARMOR LAYER IS LISTED ON 5x5' GRIDS



CU8 LOCATION PLAN
NOT TO SCALE

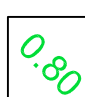
PARSONS		DRAWING TITLE	
GE COMPANY - PARSONS PROJECT OFFICE		CU8	
BUILDING 40-1, 381 BROADWAY		TYPE "B" MEDIUM VELOCITY	
FORT EDWARD, N.Y. 12828 (518) 746-5311		CAP ARMOR LAYER	
DESIGNED BY: JHC	CHECKED BY: JHC	DRAWING NO.	ACCEPTANCE SURVEY
DATE: 12/02/09	APPROVED BY: JHC	SCALE: AS SHOWN	
			CU8-2
			442209.01401

LEGEND

-  10x10' GRID WITHIN DESIGN GUIDELINES
-  10x10' GRID LESS THAN DESIGN GUIDELINES
-  10x10' GRID ABOVE DESIGN GUIDELINES
-  BUCKET REFUSAL ENCOUNTERED VIA DREDGING
-  CU BOUNDARY
-  NEARSHORE BORDER (117.5 FEET)
-  MUD - RIP RAP INTERFACE
-  5 FOOT INTERFACE OFFSET
-  POTENTIAL LOCATION FOR RIVERINE FRINGING WETLAND CONSTRUCTION (PLANTING BY OTHERS)

NOTES:




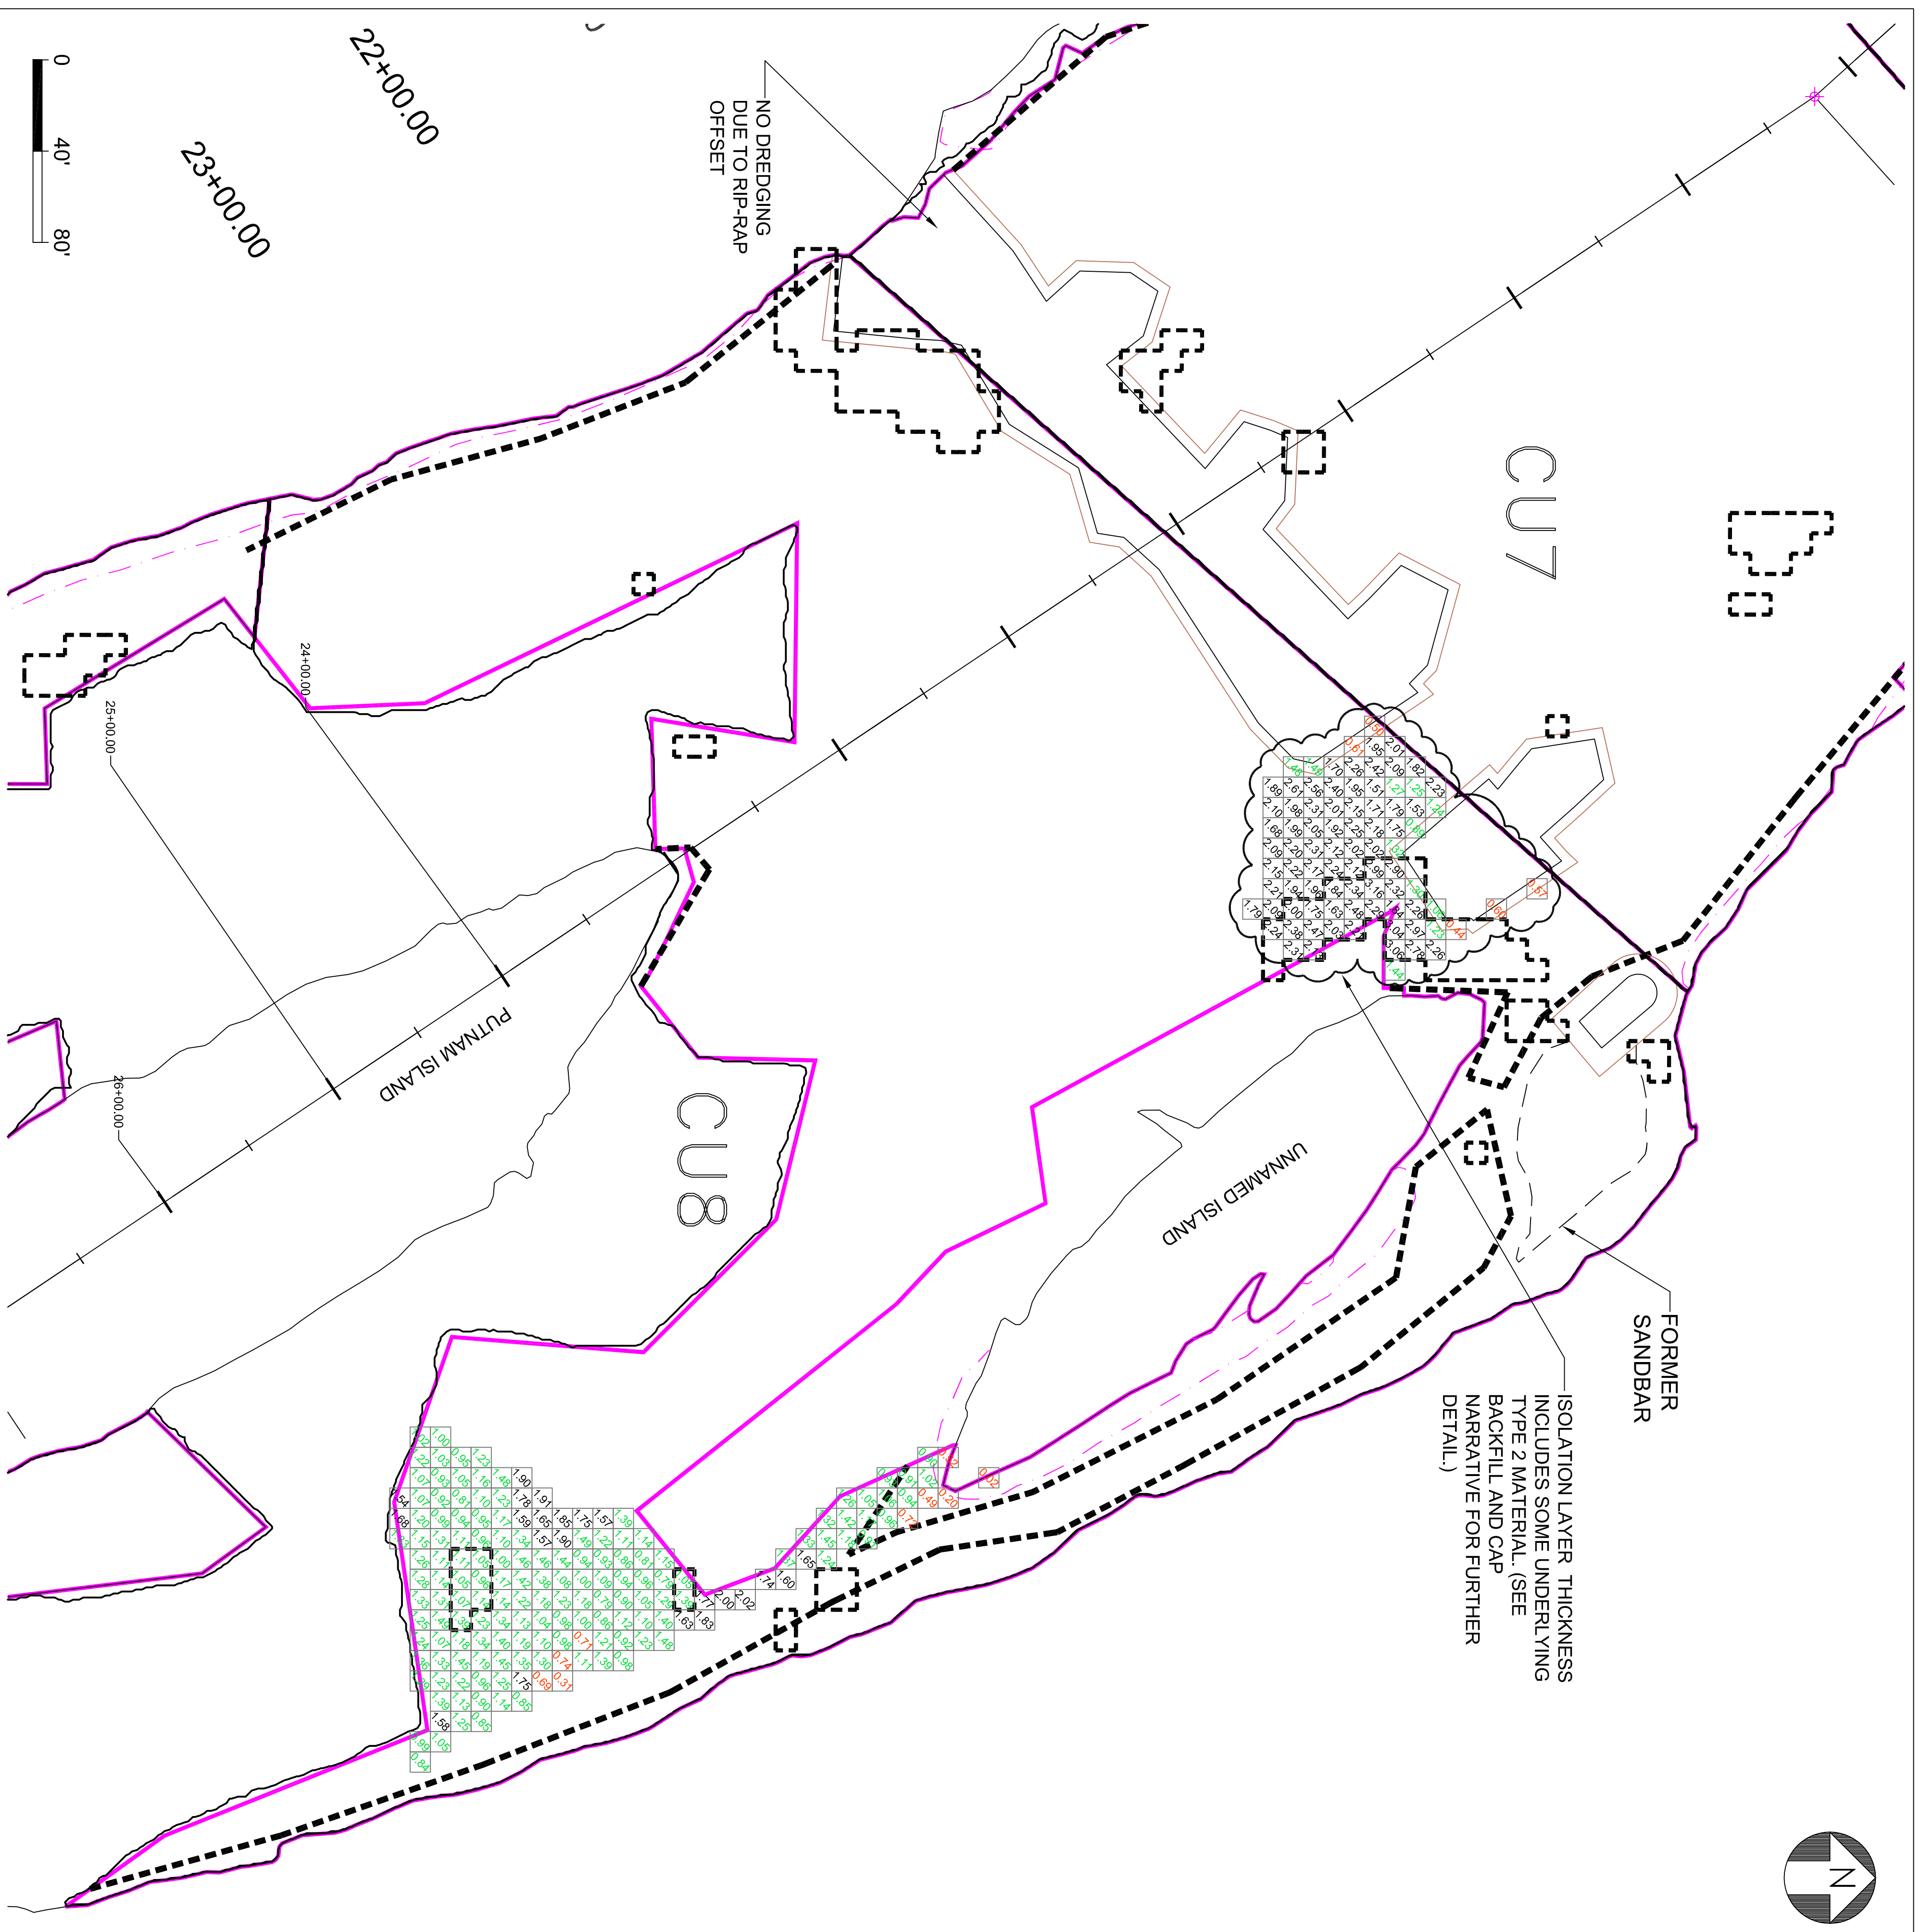



1. OSI MULTIBEAM SURVEY ON NOVEMBER 12 AND 15, 2009.
2. THICKNESS OF ISOLATION LAYER IS LISTED IN 10X10' GRIDS.

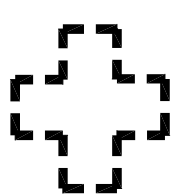


FILE NAME: E:\FORT EDWARD\PARSONS\CAP TYPE B - MED-HIGH(10X10)-LAYER A\CAP LAYER A 10X10 CU8-2.DWG
 PLOT DATE: 12/2/2009 3:32 PM PLOTTED BY: 48606


PARSONS		DRAWING TITLE	
GEORGE W. PARSONS PROJECT OFFICE BUILDING 40-1, 381 BROADWAY FORT EDWARD, N.Y. 12828 (518) 746-5311		CU8 TYPE "B" MEDIUM VELOCITY CAP ISOLATION LAYER ACCEPTANCE SURVEY	
DRAWN BY: JHC	CHECKED BY: JHC	DRAWING NO: CU8-1	SCALE: AS SHOWN
DATE: 12/02/09	APPROVED BY: JHC	JOB: 442209.01-01	

LEGEND

-  BUCKET REFUSAL AREA ENCOUNTERED DURING DREDGING
-  CU BOUNDARY
-  MUD - RIP RAP INTERFACE
-  5' INTERFACE OFFSET
-  POTENTIAL LOCATION FOR RIVERINE FRINGING WETLAND CONSTRUCTION (PLANTING BY OTHERS)
-  NEARSHORE BORDER (117.5 FEET)
-  PROPOSED RIVERINE FRINGING WETLAND AREA

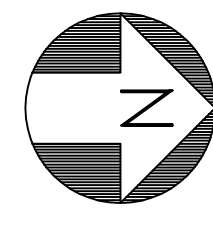

PROPOSED RIVERINE FRINGING WETLAND AREA BASED ON SHORELINE DISTURBANCE IN CU7 (1176 FT²) (SEE NOTE 3)

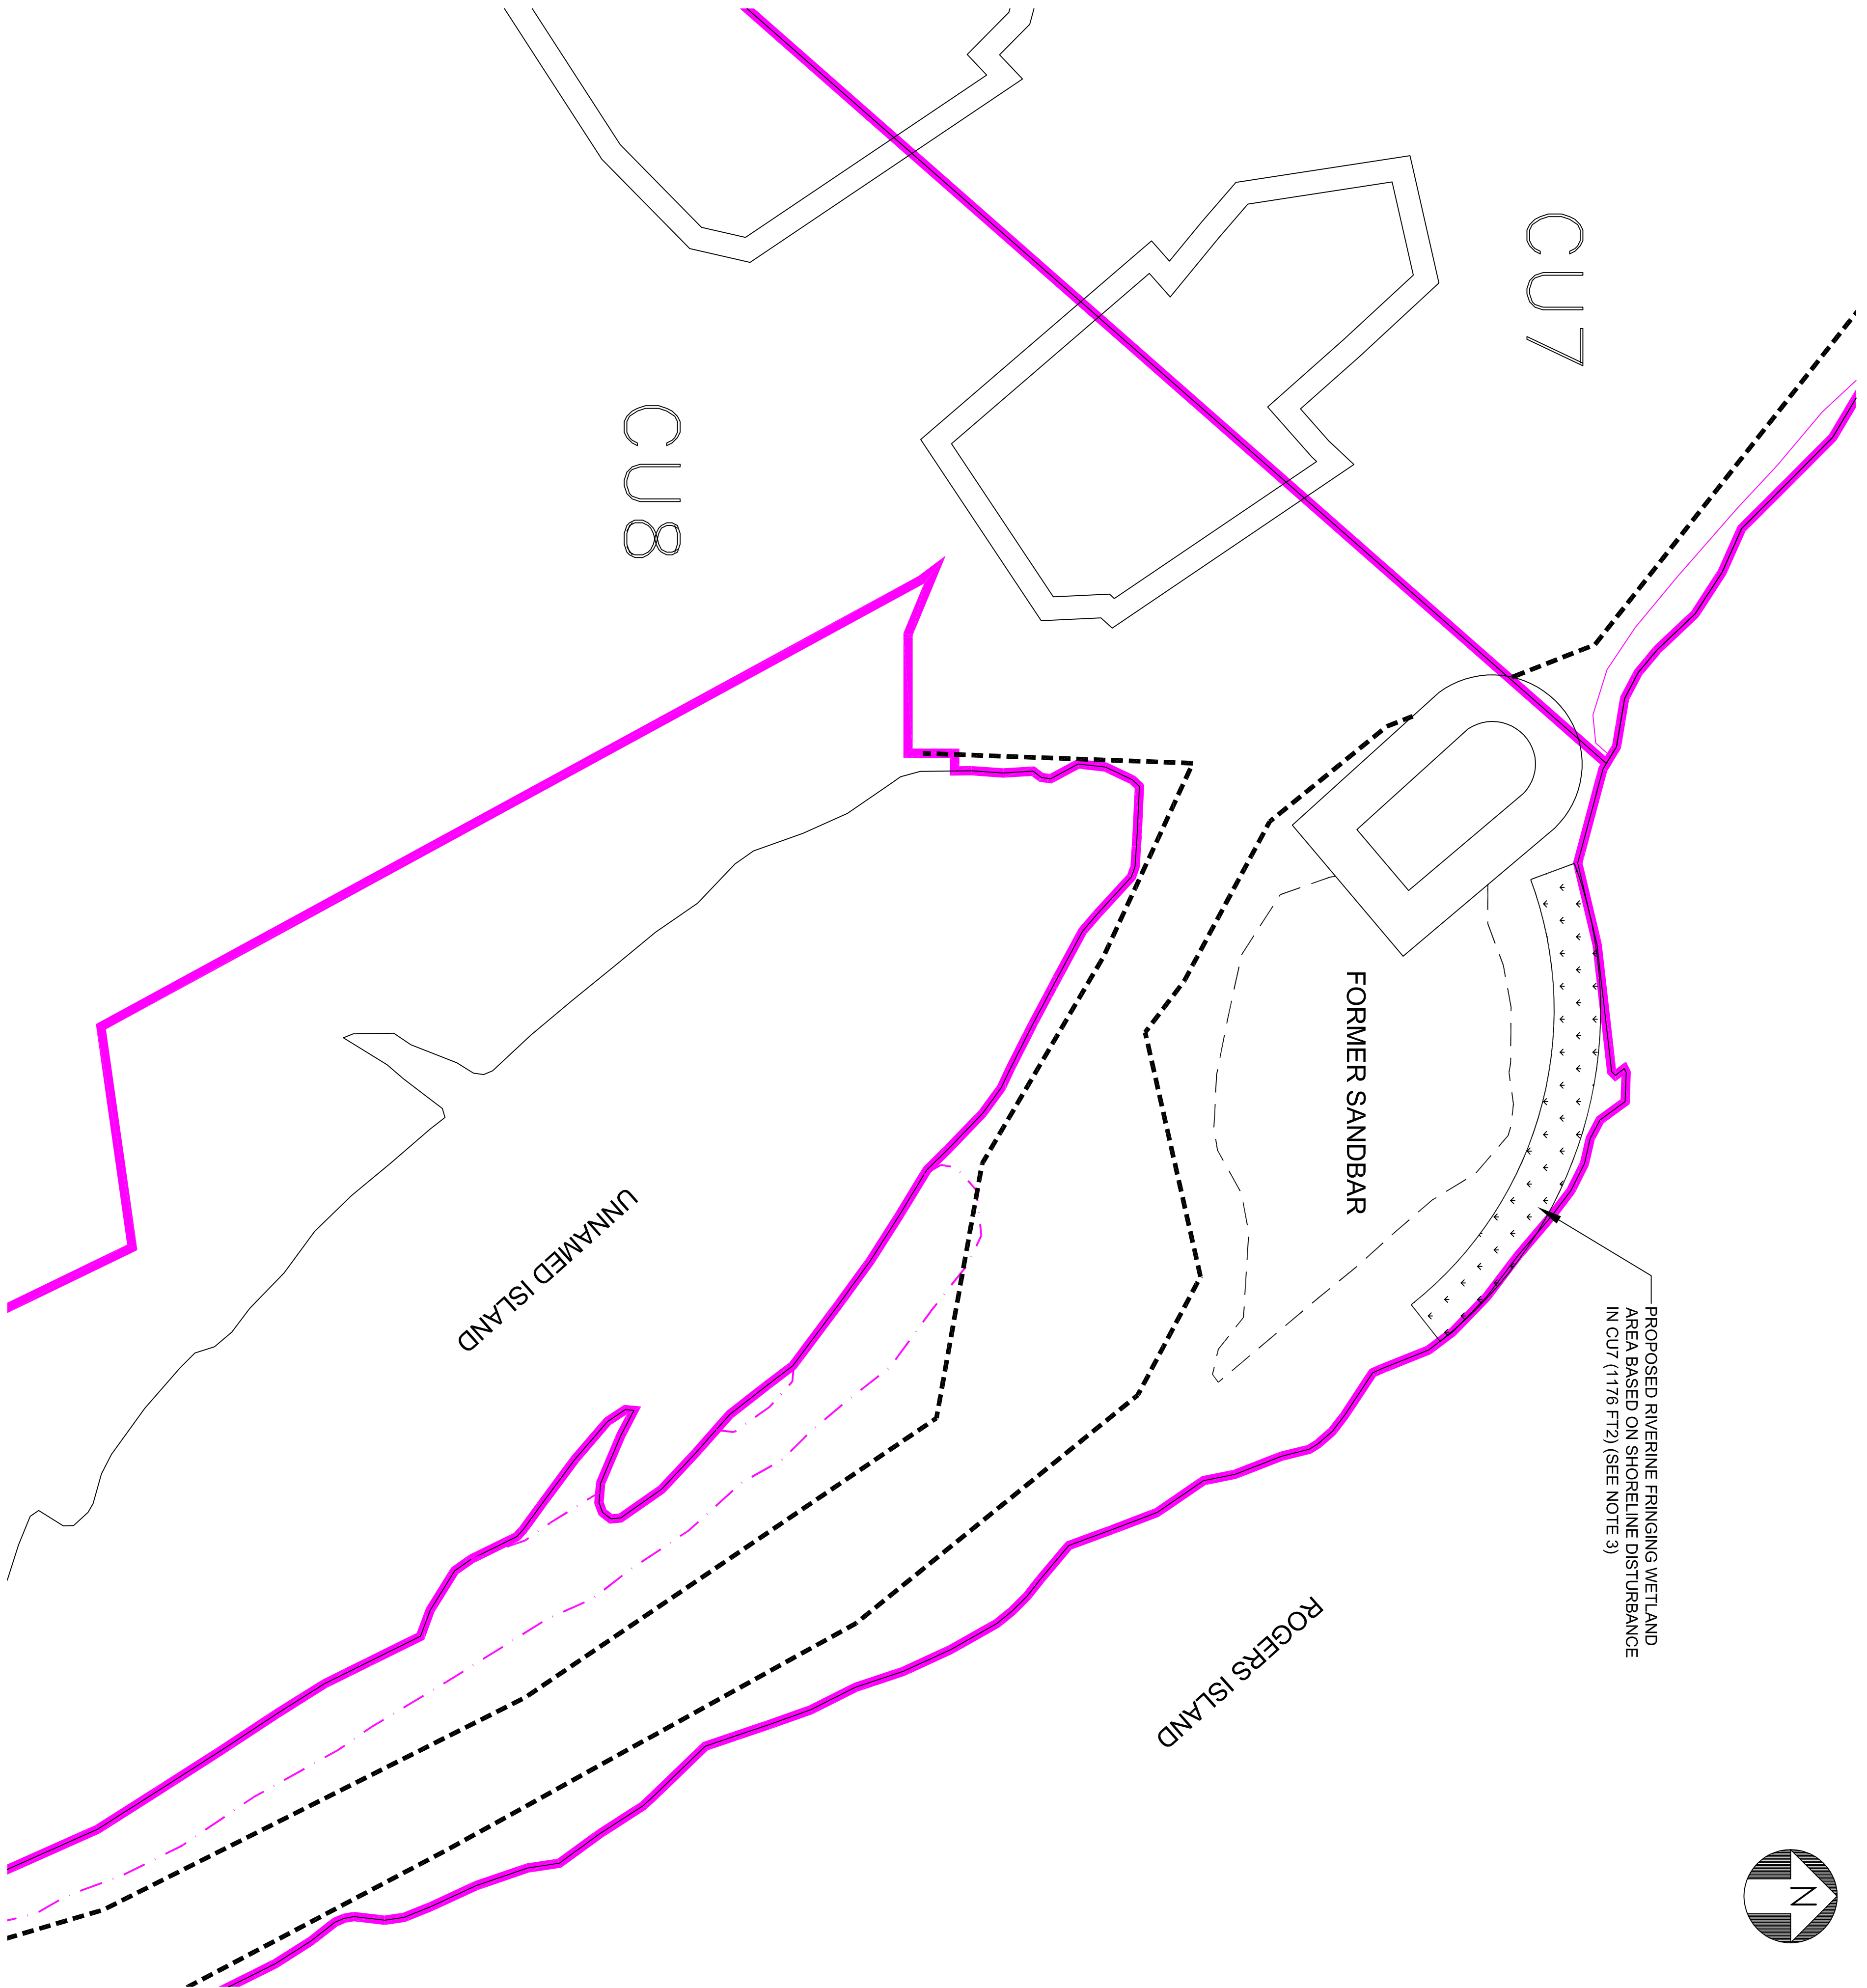



NOTES:

1. BACKFILL TO BE PLACED IN ACCORDANCE WITH SECTION 13720 AND DESIGN DRAWINGS B-0021-SK1 AND B-0020-SK1.
2. RIVERINE FRINGING WETLAND TO BE CONSTRUCTED IN ACCORDANCE WITH DESIGN DRAWING B-0020-SK1.
3. BACKFILL IN THIS AREA TO BE PLACED IN ACCORDANCE WITH TYPICAL RIVERINE FRINGING WETLAND CROSS SECTION AS SHOWN ON CONTRACT DRAWING B-0021-SK1.

RECORD
DRAWING

PARSONS		DRAWING TITLE	
3600 MARKET STREET FORT EDWARD, N.Y. 12828 (518) 746-5311		RIVERINE FRINGING WETLAND PLAN	
DRAWN BY: JHG CHECKED BY: JWG	DATE: 12/02/09	DRAWING NO.: CU8-WIL	VERSION: A
		AS SHOWN JOB: 442209.01-01	

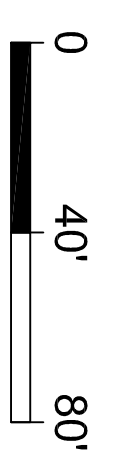


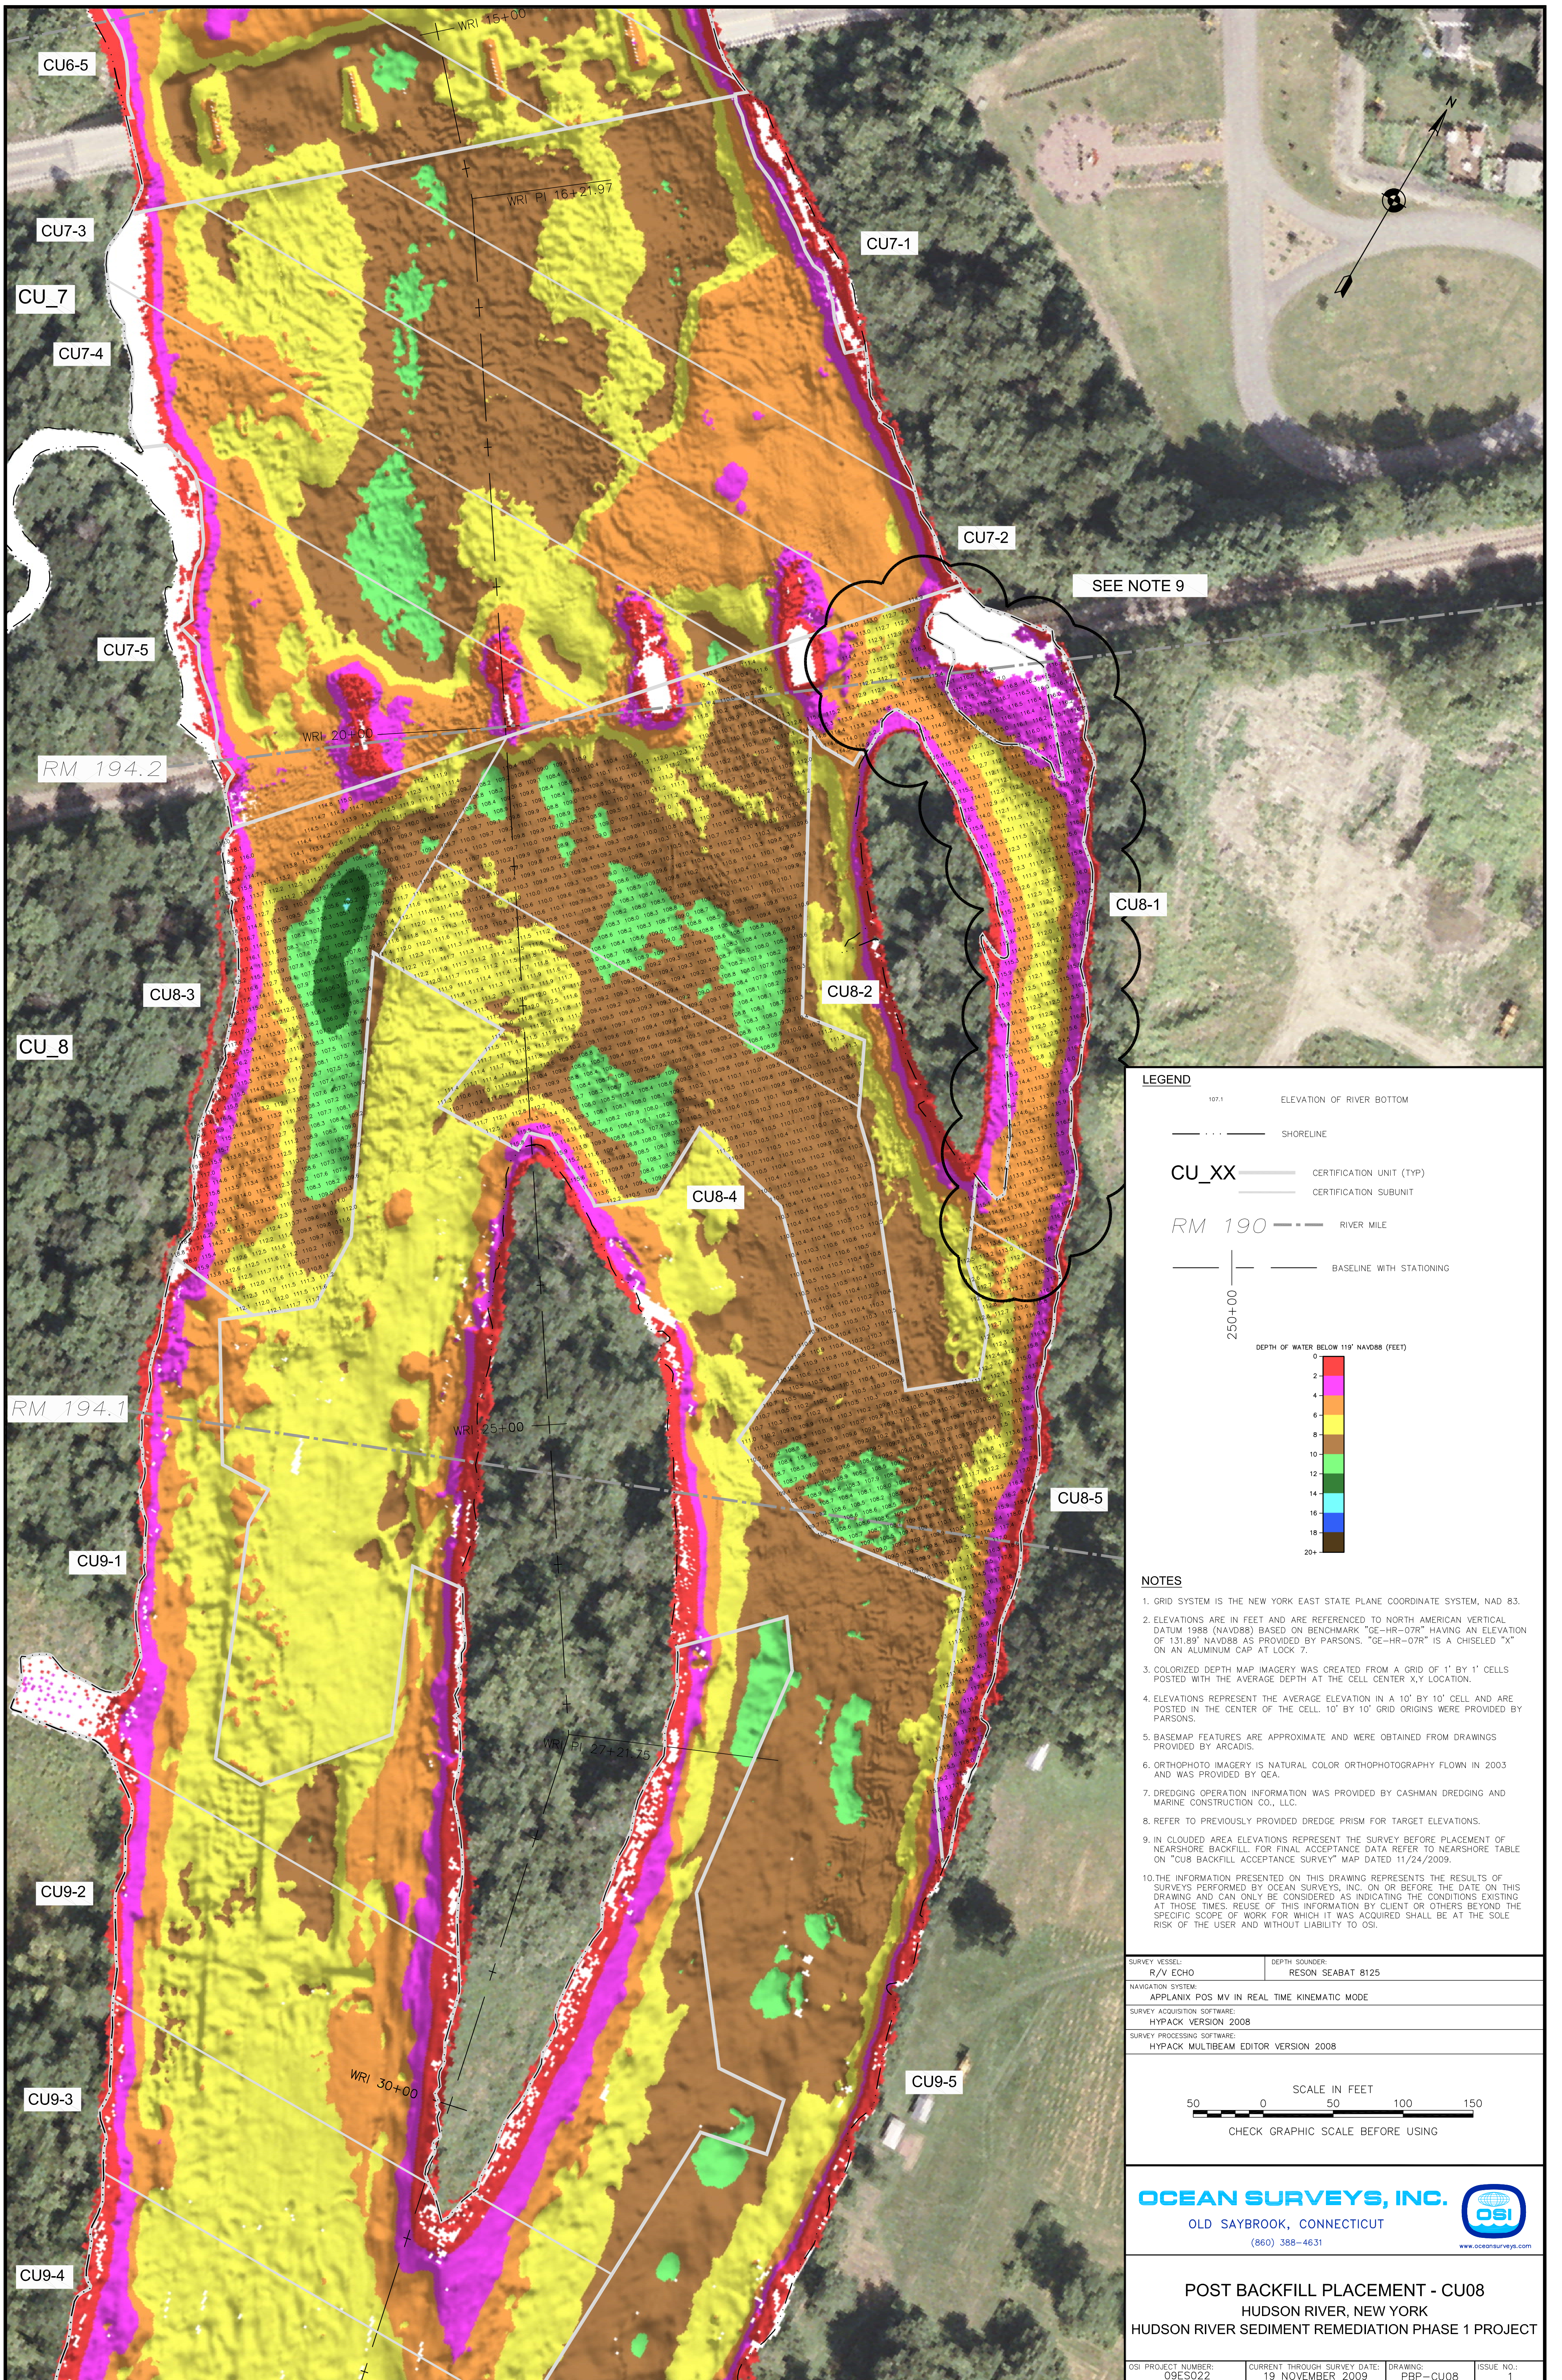

SEE NOTE 9


LEGEND

- 107.1 ELEVATION OF RIVER BOTTOM
- SHORELINE
- CU_XX CERTIFICATION UNIT (TYP)
- CERTIFICATION SUBUNIT
- RM 190 RIVER MILE
- BASELINE WITH STATIONING

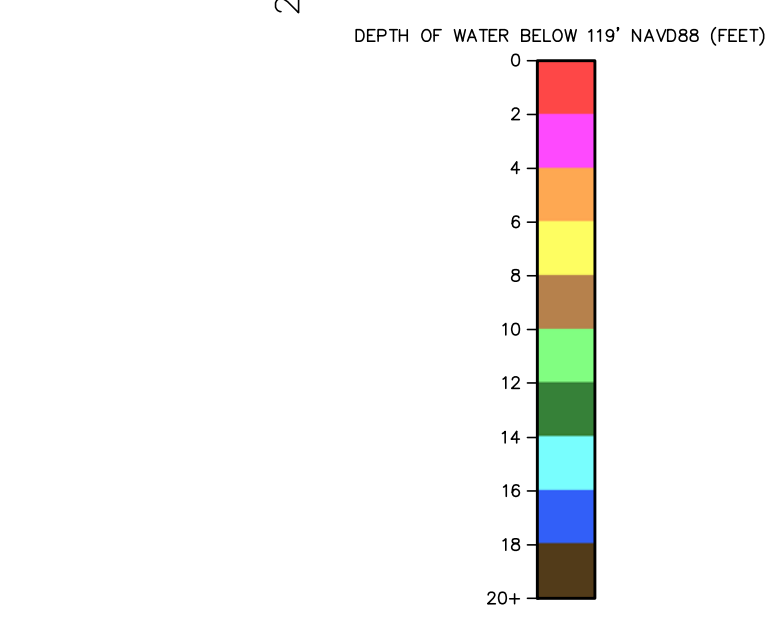

- NOTES**
- GRID SYSTEM IS THE NEW YORK EAST STATE PLANE COORDINATE SYSTEM, NAD 83.
 - ELEVATIONS ARE IN FEET AND ARE REFERENCED TO NORTH AMERICAN VERTICAL DATUM 1988 (NAVD88) BASED ON BENCHMARK "GE-HR-07R" HAVING AN ELEVATION OF 131.89' NAVD88 AS PROVIDED BY PARSONS. "GE-HR-07R" IS A CHISELED "X" ON AN ALUMINUM CAP AT LOCK 7.
 - COLORIZED DEPTH MAP IMAGERY WAS CREATED FROM A GRID OF 1' BY 1' CELLS POSTED WITH THE AVERAGE DEPTH AT THE CELL CENTER X,Y LOCATION.
 - ELEVATIONS REPRESENT THE AVERAGE ELEVATION IN A 10' BY 10' CELL AND ARE POSTED IN THE CENTER OF THE CELL. 10' BY 10' GRID POINTS WERE PROVIDED BY PARSONS.
 - BASEMAP FEATURES ARE APPROXIMATE AND WERE OBTAINED FROM DRAWINGS PROVIDED BY ARCADIS.
 - ORTHO PHOTO IMAGERY IS NATURAL COLOR ORTHOPHOTOGRAPHY FLOWN IN 2003 AND WAS PROVIDED BY OEA.
 - DREDGING OPERATION INFORMATION WAS PROVIDED BY CASHMAN DREDGING AND MARINE CONSTRUCTION CO., LLC.
 - REFER TO PREVIOUSLY PROVIDED DREDGE PRISM FOR TARGET ELEVATIONS.
 - IN CLOUDED AREA ELEVATIONS REPRESENT THE SURVEY BEFORE PLACEMENT OF NEARSHORE BACKFILL. FOR FINAL ACCEPTANCE DATA REFER TO NEARSHORE TABLE ON "CUS BACKFILL ACCEPTANCE SURVEY" MAP DATED 11/24/2009.
 - THE INFORMATION PRESENTED ON THIS DRAWING REPRESENTS THE RESULTS OF SURVEYS PERFORMED BY OCEAN SURVEYS, INC. ON OR BEFORE THE DATE ON THIS DRAWING AND CAN ONLY BE CONSIDERED AS INDICATING THE CONDITIONS EXISTING AT THOSE TIMES. REUSE OF THIS INFORMATION BY CLIENT OR OTHERS BEYOND THE SPECIFIC SCOPE OF WORK FOR WHICH IT WAS ACQUIRED SHALL BE AT THE SOLE RISK OF THE USER AND WITHOUT LIABILITY TO OSI.

SURVEY VESSEL: R/V ECHO	DEPTH SOUNDER: RESON SEABAT 8125
NAVIGATION SYSTEM: APPLANIX POS MV IN REAL TIME KINEMATIC MODE	
SURVEY ACQUISITION SOFTWARE: HYPACK VERSION 2008	
SURVEY PROCESSING SOFTWARE: HYPACK MULTIBEAM EDITOR VERSION 2008	

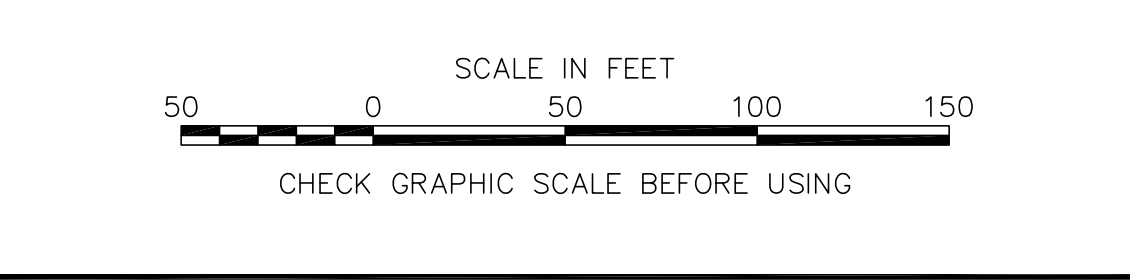

OCEAN SURVEYS, INC.
 OLD SAYBROOK, CONNECTICUT
 (860) 388-4631

www.oceansurveys.com

POST BACKFILL PLACEMENT - CU08
 HUDSON RIVER, NEW YORK
 HUDSON RIVER SEDIMENT REMEDIATION PHASE 1 PROJECT

OSI PROJECT NUMBER: 09ES022	CURRENT THROUGH SURVEY DATE: 19 NOVEMBER 2009	DRAWING: BFP-CU08	ISSUE NO.:
			1

Correspondence
(Letters and E-mails)

Inglis, Andrew A (GE, Corporate)

From: King.David@epamail.epa.gov
Sent: Friday, November 27, 2009 4:17 PM
To: Inglis, Andrew A (GE, Corporate)
Cc: Jakob, Carl (GE, Corporate, non-ge); GKlawinski@ene.com; MJohnson@louisberger.com; Kruppenbacher, Timothy A (GE, Corporate); USACE_HRFO@roadrunner.com
Subject: Re: Placement of alternative material in CU8

Andrew that is OK. the flow is too fast for smaller material.

Dave

"Inglis, Andrew
A (GE,
Corporate)"
<andrew.inglis@g
e.com>

11/25/2009 01:52
PM

David King/R2/USEPA/US@EPA

"Kruppenbacher, Timothy A (GE,
Corporate)"
<timothy.kruppenbacher@ge.com>,
<MJohnson@louisberger.com>,
<USACE_HRFO@roadrunner.com>,
<GKlawinski@ene.com>, "Jakob,
Carl (GE, Corporate, non-ge)"
<carl.jakob@parsons.com>

To
cc
Subject
Placement of alternative material
in CU8

Dave,

Based on reviews of the dredging contractor's post-placement surveys of CU8 and records of placed material, significant run-out of placed nearshore backfill is being experienced behind the island in CU8. To mitigate this situation we are requesting approval to fill deeper areas with Type N stone then place Type 1 or Type 2 (as required in the design) on top of the Type N material.

The type N material would be placed upto elevation 116' then type 2 or type 1 used to raise the elevations to the required 117.5-119' bench.

Let me know if this is acceptable to EPA.

Thanks,

Andrew A. Inglis
Dredging Task Leader
GE

T +1 518-746-5256

381 Broadway

CU-17

Form 2

CU Certification of Completion

CU BACKFILL/ENGINEERED CAP COMPLETION APPROVAL - FORM 2						
Reporting Date	10/16/2009			Placement Start Date	9/21/2009	
CU Number	17			Placement End Date	10/11/2009	
Approximate CU Centroid	Northing	1596601.07	Easting	737413.7703	NY State NAD 83	
CU Size	4.99	Acres				
Backfill Area	4.47	Acres				
Cap Area	0	Acres				
Backfill Surface Mean Tri+ PCBs Concentration (when required)				NA	mg/kg	
Number of nodes sampled				NA	mg/kg	
Backfill x	Type of Backfill Type 1, Type 2, Nearshore	Reference to appropriate drawings attached to Approval Form 1 CU 17 Backfill Plan, 9/21/09				
Cap	Type of Cap	Reference to appropriate drawings attached to Approval Form 1				
CU Checklist		Indicate one of the following			Reviewer Initial Acceptance	
Item	Attached	Not Applicable	GE	EPA		
Drawing of Installed Backfill/Cap (with record drawing details, thickness and sample locations [when backfill/cap are placed])	x					
Where applicable in backfill areas provide the following: Sample locations (coordinates), depths, Aroclor and Tri+ PCB concentrations collected including analytical data, field observations, (hard copy and electronic copies [in database format or equivalent])		x				
Comments						
Refer to attached Narrative Backfill Summary and CU 17 Backfill Placement Drawing.						
Upon signing this document, GE certifies that the backfill/cap has been installed satisfactorily and that no further backfill placement or capping is required for this CU. These remedial activities exclude long term operation, monitoring, maintenance and adaptive management at the CU. EPA accepts this certification.						
Signature of GE Representative			Signature of EPA Representative			
Signature			Signature			
Name			Name			
Date			Date			

Narrative

CU 17

Narrative Summary of Backfill and EPA Backfill Agreements

1.0 Backfill Placement

Backfill was placed in accordance with the CU 17 Backfill Plan Record Drawing, dated October 16, 2009. A multi-beam bathymetric survey for CU 17 was performed after final backfill placement on October 12, 2009, as shown on the attached CU 17 Post Backfill Placement Acceptance Drawing, dated October 16, 2009.

2.0 EPA Field Agreements Specific to CU 17 Backfill

The EPA field agreements specific to CU 17 that relate to backfill are:

1. As noted on the CU 17 backfill plan, during the September 11, 2009 daily meeting EPA agreed that placing backfill in the small irregular shaped areas in the navigational channel that were below elevation 102 feet would be unproductive and requested that GE remove those backfill areas from the plan.
2. As noted on the CU 17 backfill plan, during the September 21, 2009 daily meeting EPA requested that GE remove 15% backfill areas from the CU 17 backfill plan pending order of priority of other CUs. EPA informed GE on October 12, 2009 that placement of 15% backfill in CU 17 will not be required.
3. During the 4:00 PM meeting on October 7, 2009, GE brought to EPA's attention that placement of Type 1 backfill at the required 3:1 slope in near shore areas of CU17 was not feasible because the physical properties of the material (natural angle of repose in a submerged state) are such that it is unable not to hold a 3:1 slope. GE reviewed and provided EPA with cross sections on October 7, 2009, which showed the apparent natural angle of repose in a submerged state for Type 1 is closer to 6:1, which are attached as part of this Form 2 package. It was decided that for the CU 17 near shore areas Type 2 backfill material will be placed to elevation 116.5' (over top of the Type 1 material that was already placed) then Type 1 backfill material will be placed from elevation 116.5' to 119'. Refer to the attached near shore detail sketch and Note 4 on the attached Backfill and Capping Plan for further details. EPA agreed with this proposal.
4. During the 4:00 PM meeting on October 13, 2009, GE provided a Draft Backfill Placement Acceptance drawing showing the difference to dredge prism in feet on a 10x10 grid. EPA

requested that the average thickness of 1 foot backfill over each acre within the CU be included on the Backfill Placement Acceptance drawings, to which GE agreed.


5. During the 4:00 PM meeting on October 14, 2009, EPA requested that Planned and Actual volumes placed be included on the Backfill Acceptance Drawings, to which GE agreed.
6. During the 4:00 PM meeting on October 13, 2009, GE and EPA reviewed survey data for placement of near shore backfill. EPA agreed that placement of near shore backfill was acceptable.

Tables

CU-17 Near-Shore Topographic Soundings Collected 2009-10-12

Published Near-Shore Locations				Near-Shore Confirmation				
Name	Easting	Northing	Target Elevation	Easting	Northing	Check Elevation	Horz. Dist	Vert Diff.
GI-E-01	737,391.50	1,597,121.22	117.5	737,392.33	1,597,121.82	119.00	1.03	1.50
				737,393.40	1,597,123.84	118.56	3.24	1.06
				737,391.82	1,597,115.31	118.83	5.92	1.33
				737,390.71	1,597,127.49	117.42	6.32	-0.08
				737,396.17	1,597,116.62	118.98	6.56	1.48
				737,385.76	1,597,126.30	116.63	7.67	-0.87
				737,386.90	1,597,114.45	116.24	8.19	-1.26
GI-E-02	737,414.40	1,597,054.60	117.5	737,414.98	1,597,054.62	118.97	0.58	1.47
				737,416.25	1,597,053.87	118.90	1.99	1.40
				737,411.59	1,597,050.99	116.97	4.58	-0.53
				737,418.73	1,597,052.19	118.03	4.95	0.53
				737,415.73	1,597,049.45	118.37	5.32	0.87
				737,414.54	1,597,060.40	118.91	5.80	1.41
				737,418.63	1,597,058.85	117.86	6.00	0.36
				737,419.83	1,597,050.56	117.92	6.76	0.42
				737,410.85	1,597,060.69	117.82	7.05	0.32
GI-E-03	737,438.50	1,596,985.78	117.5	737,438.56	1,596,988.14	117.44	2.36	-0.06
GI-E-04	737,439.34	1,596,917.66	117.5	737,440.83	1,596,918.49	117.66	1.71	0.16
GI-E-05	737,452.25	1,596,898.75	117.5	737,451.44	1,596,897.53	117.36	1.47	-0.14
				737,454.21	1,596,901.70	117.54	3.54	0.04
				737,455.89	1,596,899.59	117.45	3.73	-0.05
GI-E-06	737,481.39	1,596,841.61	117.5	737,482.37	1,596,841.03	118.67	1.14	1.17
				737,482.08	1,596,837.04	117.98	4.63	0.48
				737,478.87	1,596,846.25	118.30	5.29	0.80
				737,484.00	1,596,836.81	118.58	5.46	1.08
				737,483.88	1,596,847.21	118.34	6.13	0.84
				737,487.55	1,596,838.28	118.40	7.00	0.90
				737,474.81	1,596,844.90	117.32	7.36	-0.18
				737,477.81	1,596,834.70	116.33	7.79	-1.17
				737,472.94	1,596,843.75	116.32	8.71	-1.18
GI-E-07	737,494.38	1,596,816.04	117.5	737,495.10	1,596,815.50	118.19	0.90	0.69
				737,497.39	1,596,818.79	118.06	4.07	0.56
				737,494.84	1,596,811.54	118.01	4.52	0.51
				737,498.14	1,596,813.48	118.25	4.55	0.75
				737,489.57	1,596,810.73	116.59	7.16	-0.92
				737,493.59	1,596,824.18	117.94	8.18	0.44
				737,488.58	1,596,822.22	117.57	8.47	0.07
				737,485.38	1,596,820.90	116.31	10.23	-1.19
GI-E-08	737,524.48	1,596,751.48	117.5	737,524.25	1,596,751.61	117.97	0.26	0.47
				737,525.27	1,596,749.47	117.50	2.16	0.00
				737,529.03	1,596,750.32	118.17	4.70	0.67
				737,531.20	1,596,751.41	117.89	6.73	0.39
GI-E-09	737,537.70	1,596,732.05	117.5	737,538.40	1,596,731.51	117.57	0.88	0.07
GI-E-10	737,578.99	1,596,660.50	117.5	737,579.63	1,596,659.76	117.90	0.98	0.40
GI-E-11	737,637.98	1,596,575.02	117.5	737,637.88	1,596,575.29	117.22	0.28	-0.28
GI-E-12	737,687.86	1,596,489.64	117.5	737,687.96	1,596,488.56	117.88	1.08	0.38
GI-E-13	737,740.81	1,596,404.30	117.5	737,740.29	1,596,404.64	116.33	0.63	-1.17
				737,741.51	1,596,404.13	116.90	0.72	-0.60
				737,740.12	1,596,404.51	116.54	0.72	-0.96
				737,742.58	1,596,405.44	117.74	2.11	0.24
				737,739.99	1,596,402.28	116.21	2.18	-1.29
				737,742.57	1,596,402.49	116.79	2.52	-0.71
				737,740.18	1,596,407.38	116.81	3.15	-0.69
				737,737.96	1,596,408.66	116.64	5.22	-0.86

Figures

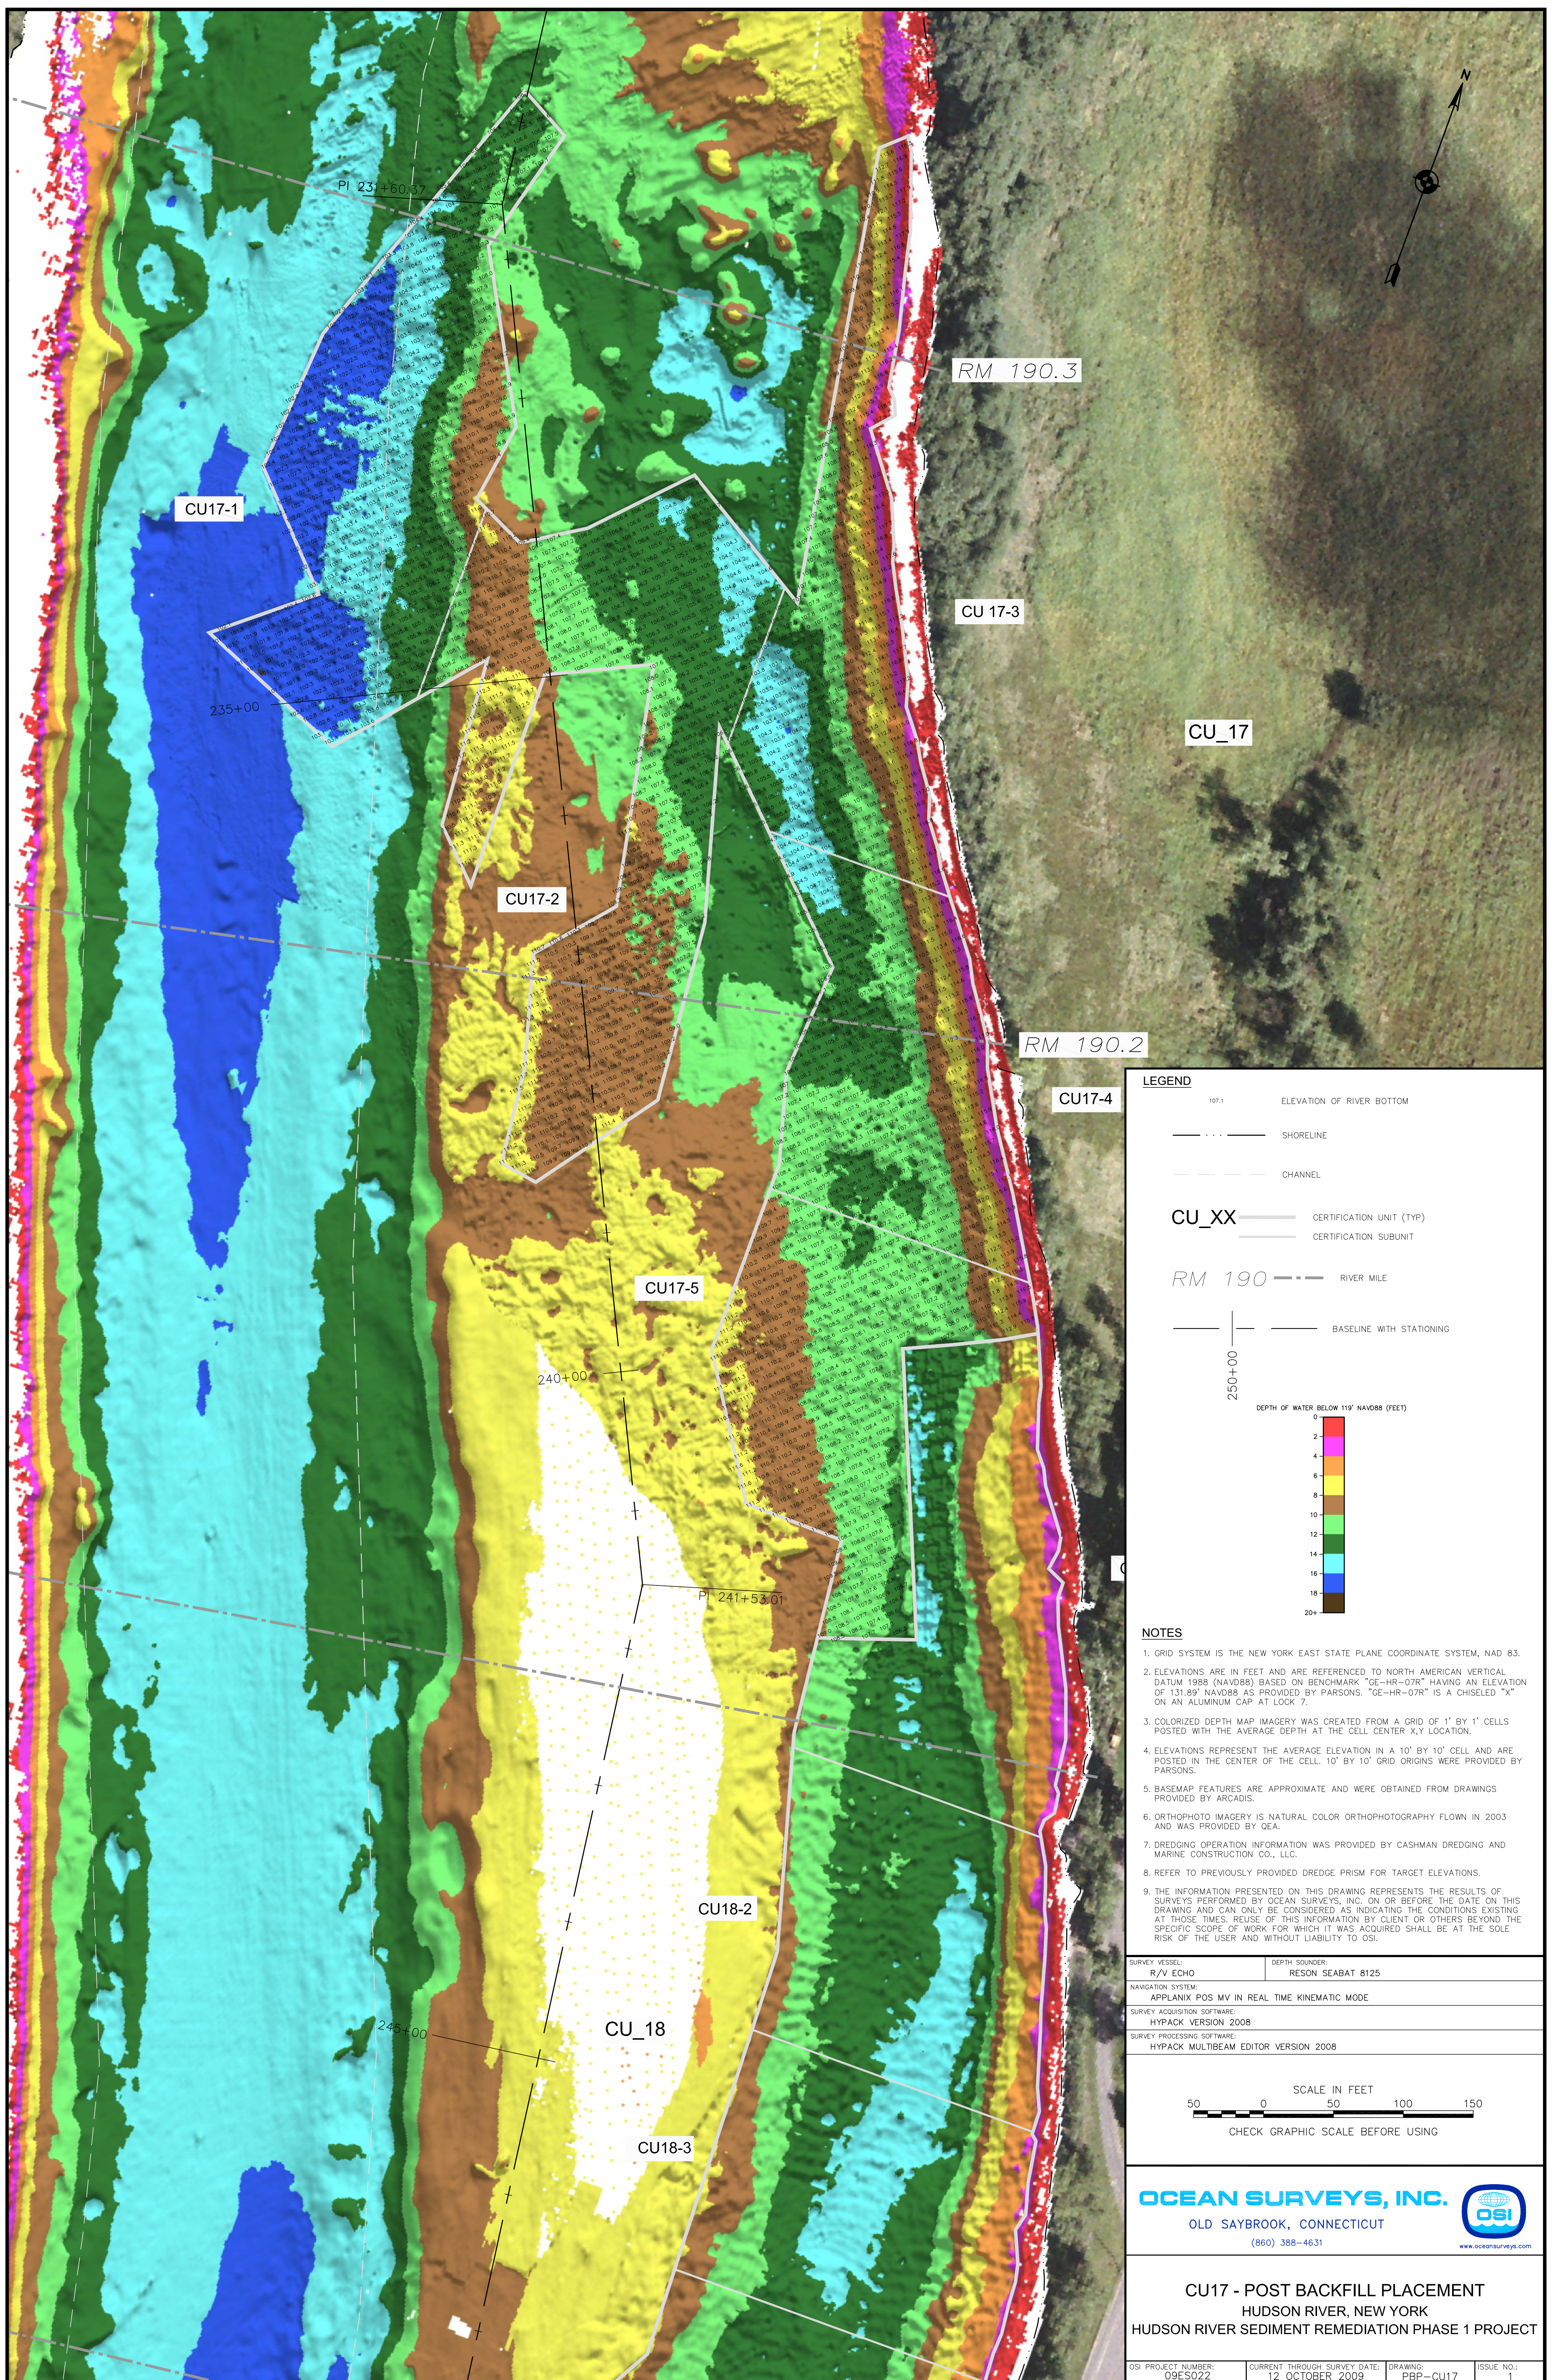

LEGEND

- 107.1 ELEVATION OF RIVER BOTTOM
- · · · — SHORELINE
- — — CHANNEL
- CU_XX** — — — CERTIFICATION UNIT (TYP)
- — — CERTIFICATION SUBUNIT
- RM 190** — — — RIVER MILE
- — — BASELINE WITH STATIONING


250+00


DEPTH OF WATER BELOW 119' NAVD88 (FEET)

0	Red
2	Orange
4	Yellow
6	Light Green
8	Green
10	Dark Green
12	Teal
14	Blue
16	Dark Blue
18	Black
20+	Black

- NOTES**
1. GRID SYSTEM IS THE NEW YORK EAST STATE PLANE COORDINATE SYSTEM, NAD 83.
 2. ELEVATIONS ARE IN FEET AND ARE REFERENCED TO NORTH AMERICAN VERTICAL DATUM 1988 (NAVD88) BASED ON BENCHMARK "GE-HR-07R" HAVING AN ELEVATION OF 131.89' NAVD88 AS PROVIDED BY PARSONS. "GE-HR-07R" IS A CHISELED "X" ON AN ALUMINUM CAP AT LOCK 7.
 3. COLORIZED DEPTH MAP IMAGERY WAS CREATED FROM A GRID OF 1' BY 1' CELLS POSTED WITH THE AVERAGE DEPTH AT THE CELL CENTER X,Y LOCATION.
 4. ELEVATIONS REPRESENT THE AVERAGE ELEVATION IN A 10' BY 10' CELL AND ARE POSTED IN THE CENTER OF THE CELL. 10' BY 10' GRID ORIGINS WERE PROVIDED BY PARSONS.
 5. BASEMAP FEATURES ARE APPROXIMATE AND WERE OBTAINED FROM DRAWINGS PROVIDED BY ARCADIS.
 6. ORTHOPHOTO IMAGERY IS NATURAL COLOR ORTHOPHOTOGRAPHY FLOWN IN 2003 AND WAS PROVIDED BY QEA.
 7. DREDGING OPERATION INFORMATION WAS PROVIDED BY CASHMAN DREDGING AND MARINE CONSTRUCTION CO., LLC.
 8. REFER TO PREVIOUSLY PROVIDED DREDGE PRISM FOR TARGET ELEVATIONS.
 9. THE INFORMATION PRESENTED ON THIS DRAWING REPRESENTS THE RESULTS OF SURVEYS PERFORMED BY OCEAN SURVEYS, INC. ON OR BEFORE THE DATE ON THIS DRAWING AND CAN ONLY BE CONSIDERED AS INDICATING THE CONDITIONS EXISTING AT THOSE TIMES. REUSE OF THIS INFORMATION BY CLIENT OR OTHERS BEYOND THE SPECIFIC SCOPE OF WORK FOR WHICH IT WAS ACQUIRED SHALL BE AT THE SOLE RISK OF THE USER AND WITHOUT LIABILITY TO OSI.

SURVEY VESSEL: R/V ECHO	DEPTH SOUNDER: RESON SEABAT 8125
NAVIGATION SYSTEM: APPLANIX POS MV IN REAL TIME KINEMATIC MODE	
SURVEY ACQUISITION SOFTWARE: HYPACK VERSION 2008	
SURVEY PROCESSING SOFTWARE: HYPACK MULTIBEAM EDITOR VERSION 2008	

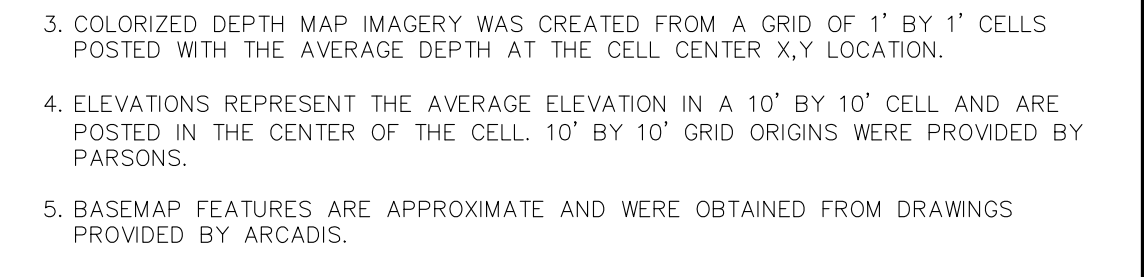


OCEAN SURVEYS, INC. 

OLD SAYBROOK, CONNECTICUT
(860) 388-4631
www.oceansurveys.com

CU17 - POST BACKFILL PLACEMENT
HUDSON RIVER, NEW YORK
HUDSON RIVER SEDIMENT REMEDIATION PHASE 1 PROJECT


OSI PROJECT NUMBER: 09ES022	CURRENT THROUGH SURVEY DATE: 12 OCTOBER 2009	DRAWING: PBP-CU17	ISSUE NO.: 1
--------------------------------	---	----------------------	-----------------

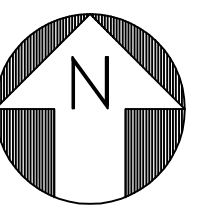

CU-17 Near-Shore Topographic Soundings Collected 2009-10-12


Design Near-Shore Locations				Near-Shore Confirmation				
Name	Easting	Northing	Target Elevation	Easting	Northing	Check Elevation	Horz. Dist.	Vert. Diff.
GI-E-01	737391.50	1597121.22	117.5	737392.33	1597121.82	119.00	1.03	1.50
GI-E-02	737414.40	1597054.60	117.5	737414.98	1597054.62	118.97	0.58	1.47
GI-E-03	737438.50	1596985.78	117.5	737438.56	1596988.14	117.44	2.36	-0.06
GI-E-04	737439.34	1596917.66	117.5	737440.83	1596918.49	117.66	1.71	0.16
GI-E-05	737452.25	1596898.75	117.5	737451.44	1596897.53	117.36	1.47	-0.14
GI-E-06	737481.39	1596841.61	117.5	737482.37	1596841.03	118.67	1.14	1.17
GI-E-07	737494.38	1596816.04	117.5	737495.10	1596815.50	118.19	0.90	0.69
GI-E-08	737524.48	1596751.48	117.5	737524.25	1596751.61	117.97	0.26	0.47
GI-E-09	737537.70	1596732.05	117.5	737538.40	1596731.51	117.57	0.88	0.07
GI-E-10	737578.99	1596660.50	117.5	737579.63	1596659.76	117.90	0.98	0.40
GI-E-11	737637.98	1596575.02	117.5	737637.88	1596575.29	117.22	0.28	-0.28
GI-E-12	737687.86	1596489.64	117.5	737687.96	1596488.56	117.88	1.08	0.38
GI-E-13	737740.81	1596404.30	117.5	737740.29	1596404.64	116.33	0.63	-1.17

Notes:
Survey data collected by Van Dusen and Steves on October 12, 2009.

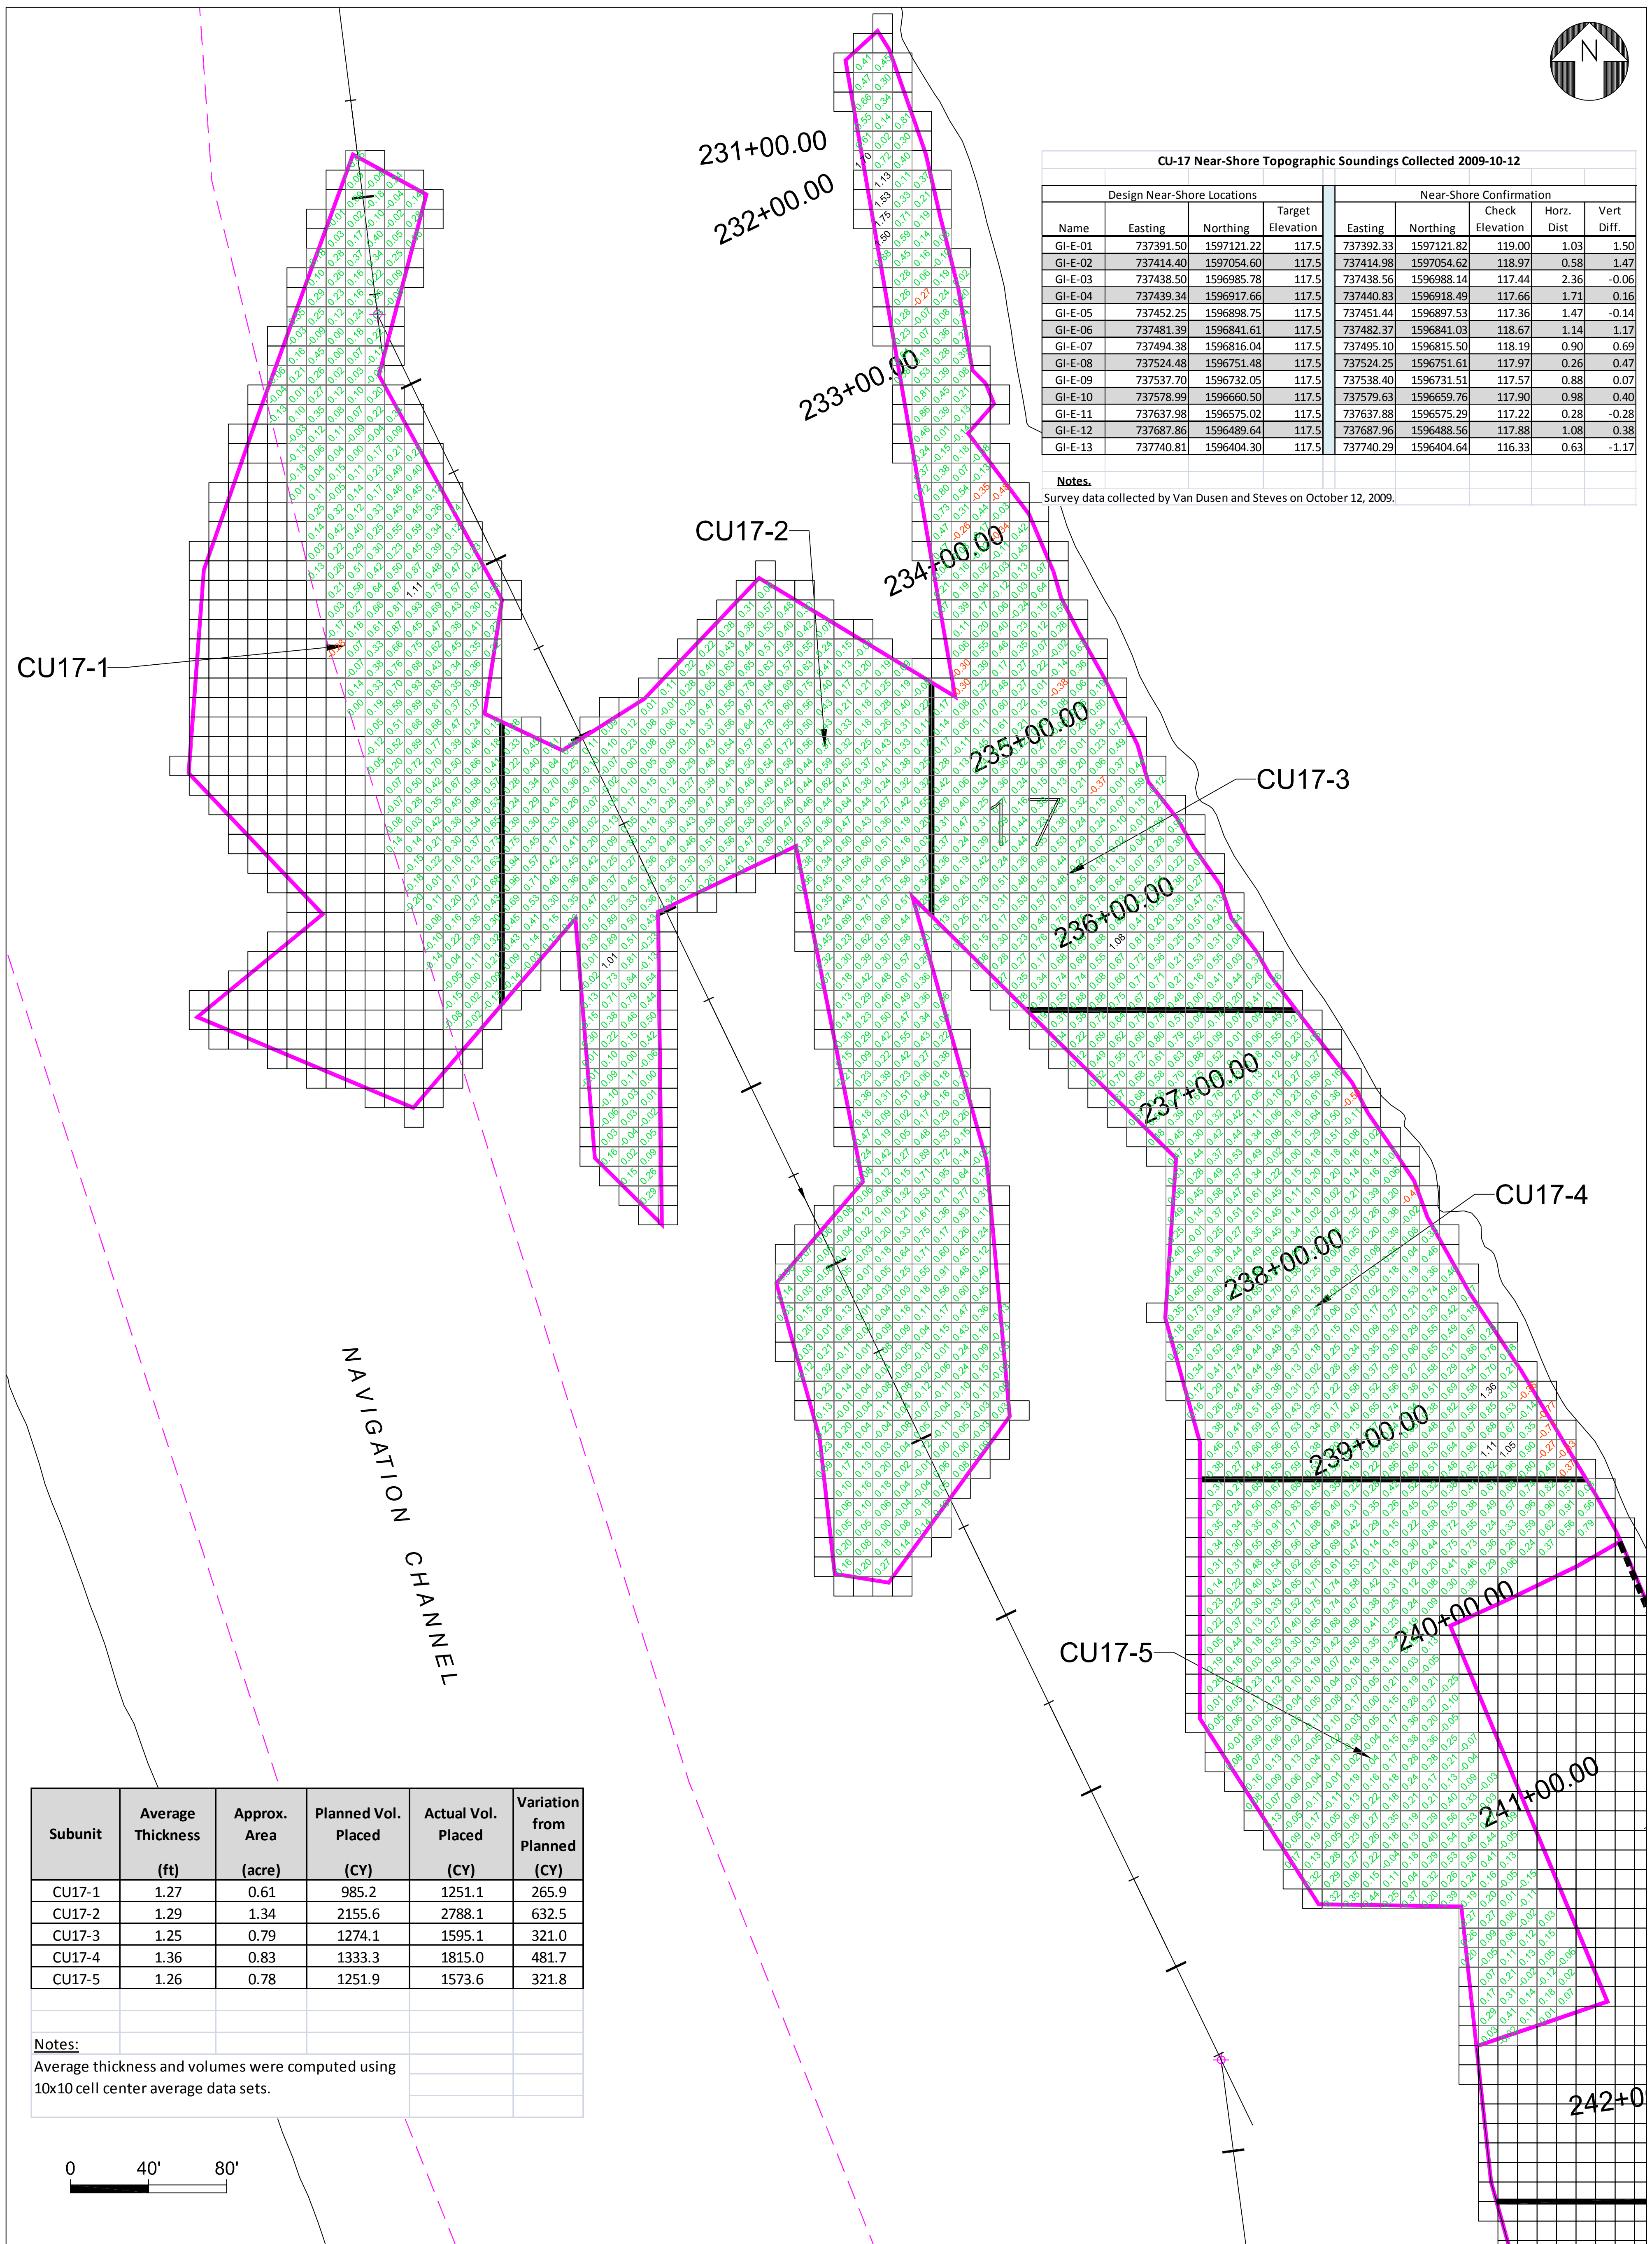

Subunit	Average Thickness (ft)	Approx. Area (acre)	Planned Vol. Placed (CY)	Actual Vol. Placed (CY)	Variation from Planned (CY)
CU17-1	1.27	0.61	985.2	1251.1	265.9
CU17-2	1.29	1.34	2155.6	2788.1	632.5
CU17-3	1.25	0.79	1274.1	1595.1	321.0
CU17-4	1.36	0.83	1333.3	1815.0	481.7
CU17-5	1.26	0.78	1251.9	1573.6	321.8

Notes:
Average thickness and volumes were computed using 10x10 cell center average data sets.

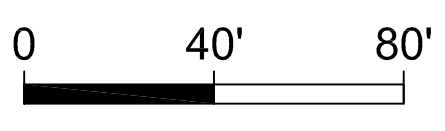



LEGEND

- 0.03 10x10 GRID WITHIN DESIGN GUIDELINES
- 0.71 10x10 GRID LESS THAN DESIGN GUIDELINES
- 1.11 10x10 GRID ABOVE DESIGN GUIDELINES
- CU BOUNDARY
- CU SUBUNIT BOUNDARY





 







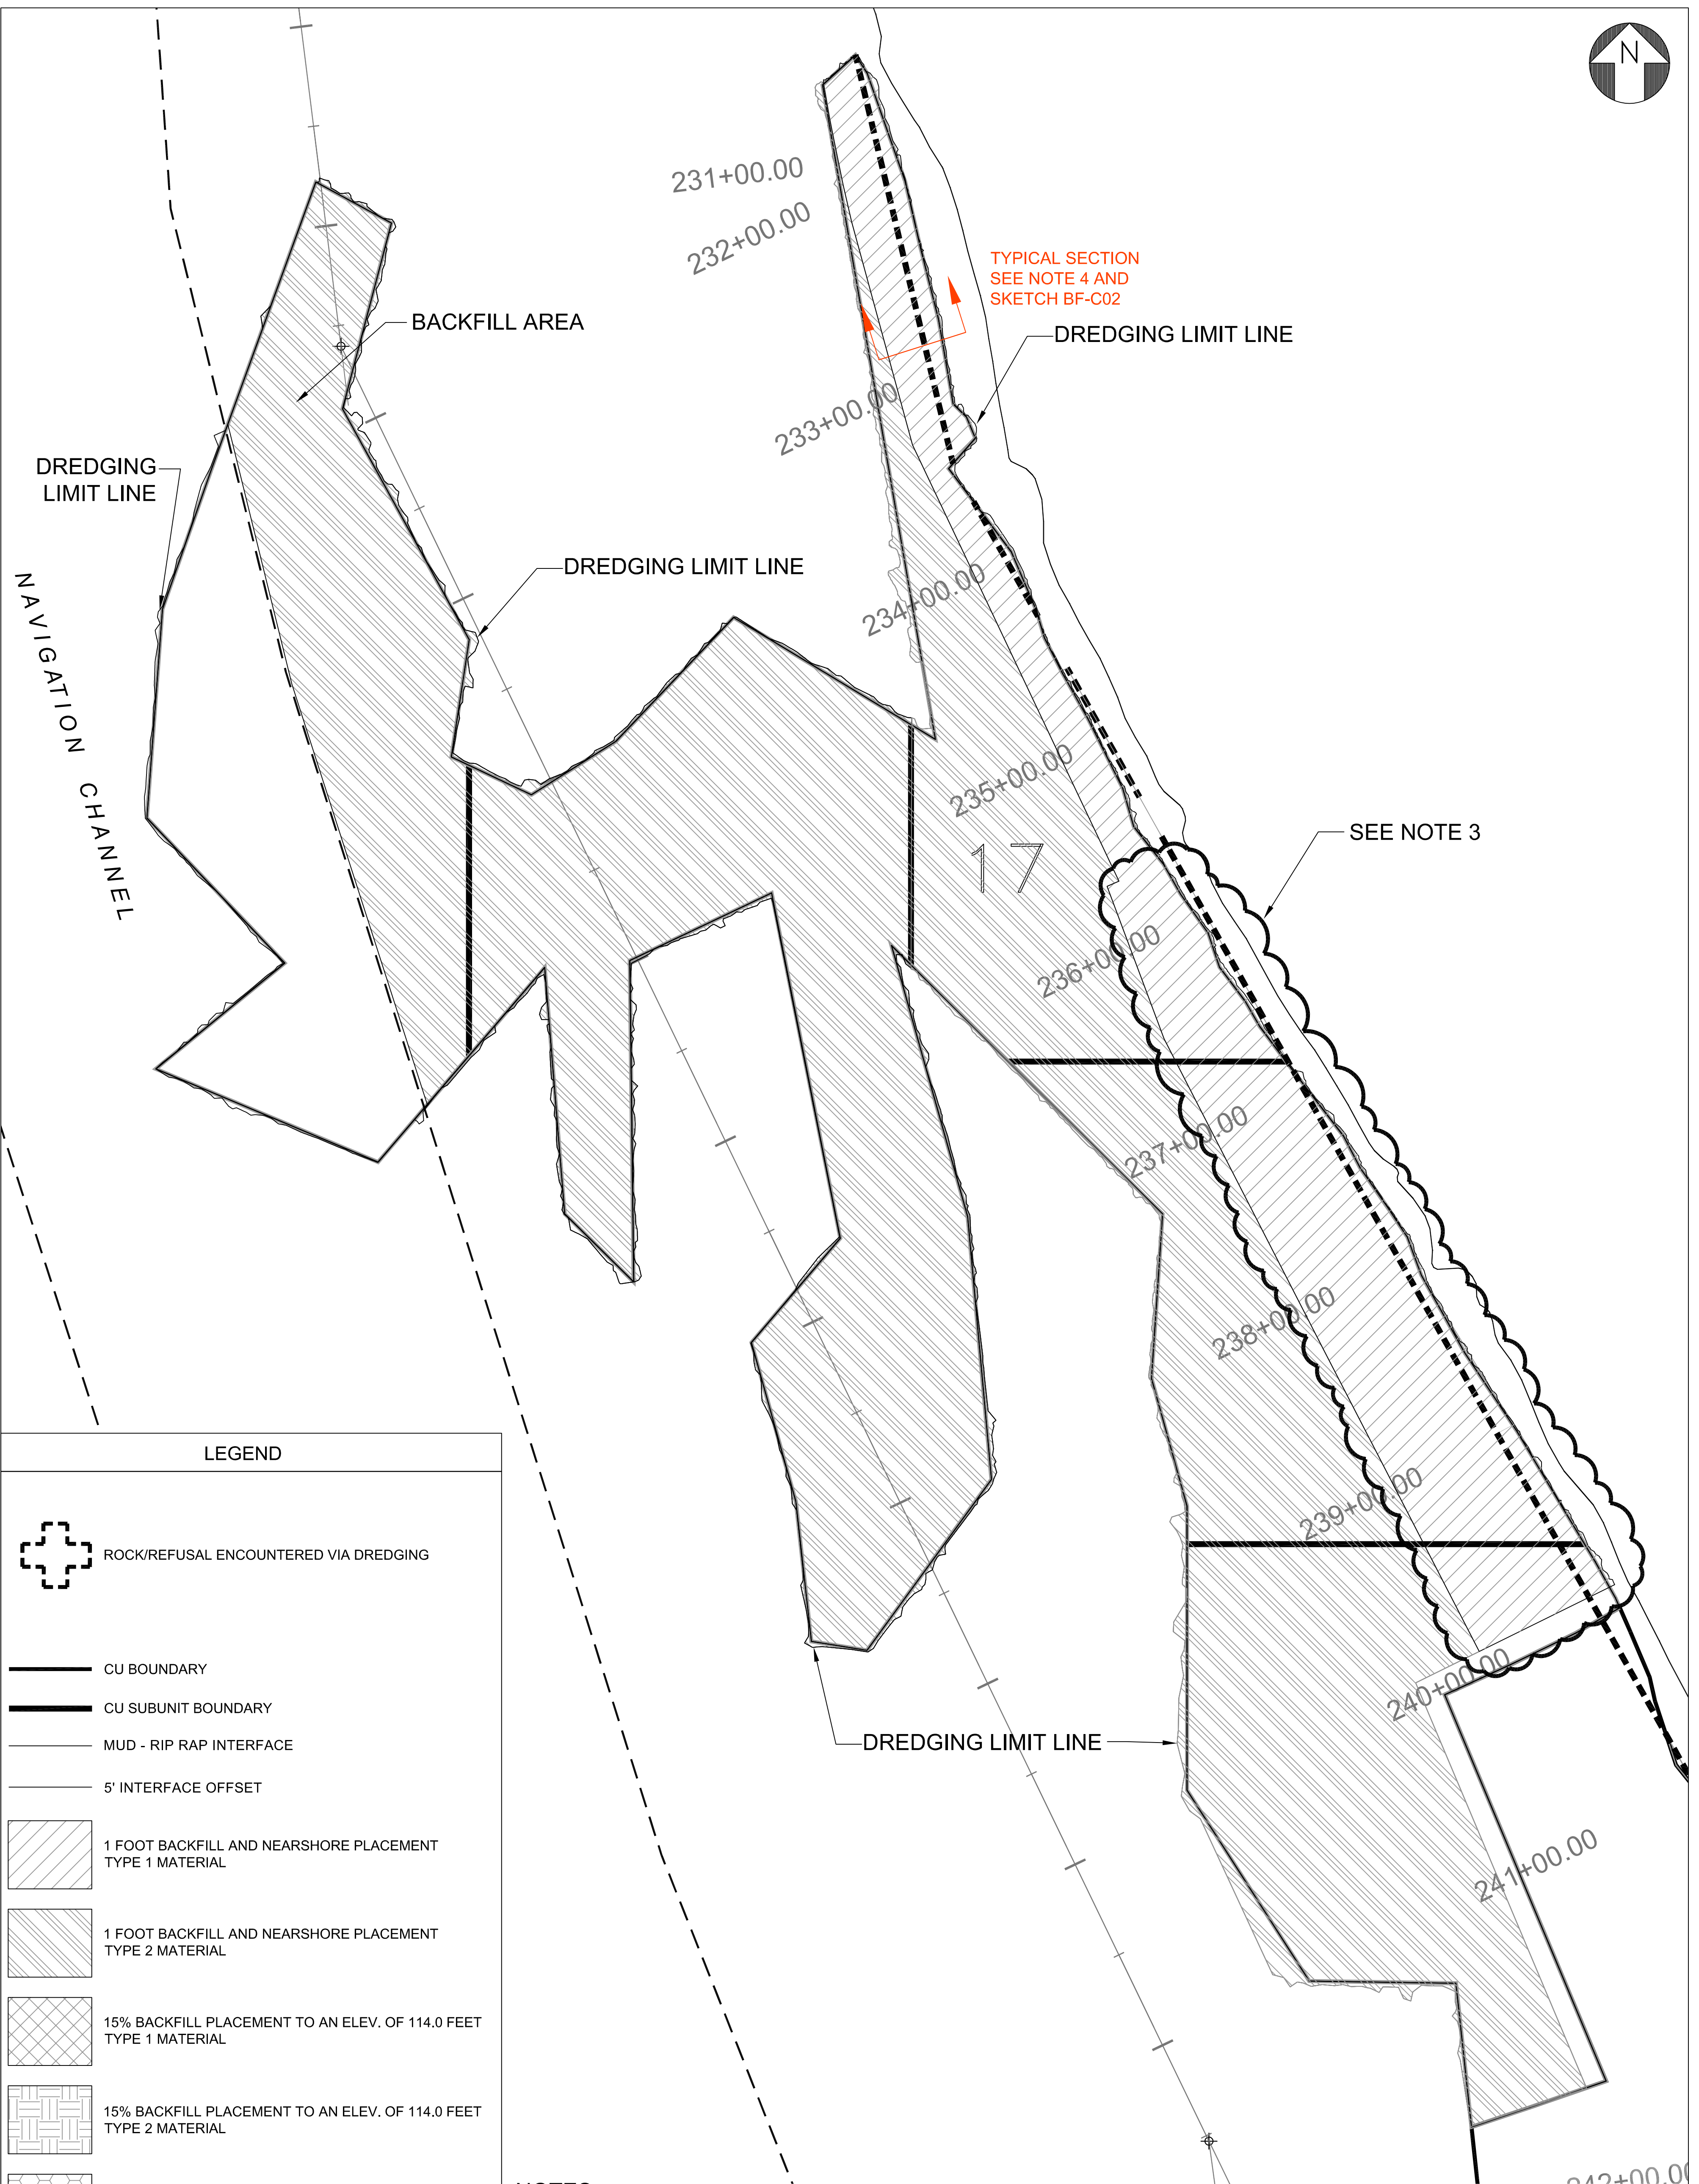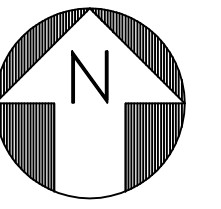



BATHYMETRY USED FROM OSI SURVEY DATE OCTOBER 12, 2009

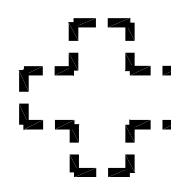CU-17
1 FOOT BACKFILL PLACEMENT
ACCEPTANCE SURVEY

PARSONS GE COMPANY - PARSONS PROJECT OFFICE BUILDING 40-1, 381 BROADWAY FORT EDWARD, N.Y. 12828 (518) 746-5311		DRAWING TITLE CU17 BACKFILL PLACEMENT ACCEPTANCE SURVEY	
DRAWN BY JHC	CHECKED BY MG	DRAWING NO. CU17	VERSION/SCALE AS SHOWN
DATE 10/16/09	APPROVED BY MG	JOB 442209.01401	

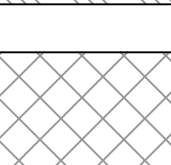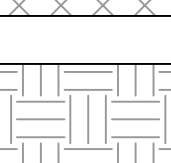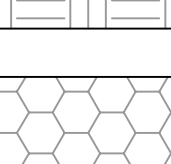

LEGEND

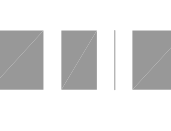-  ROCK/REFUSAL ENCOUNTERED VIA DREDGING
-  CU BOUNDARY
-  CU SUBUNIT BOUNDARY
-  MUD - RIP RAP INTERFACE
-  5' INTERFACE OFFSET
-  1 FOOT BACKFILL AND NEARSHORE PLACEMENT TYPE 1 MATERIAL
-  1 FOOT BACKFILL AND NEARSHORE PLACEMENT TYPE 2 MATERIAL
-  15% BACKFILL PLACEMENT TO AN ELEV. OF 114.0 FEET TYPE 1 MATERIAL
-  15% BACKFILL PLACEMENT TO AN ELEV. OF 114.0 FEET TYPE 2 MATERIAL
-  15% BACKFILL PLACEMENT TO ORIGINAL BATHYMETRY TYPE 1 MATERIAL
-  15% BACKFILL PLACEMENT TO ORIGINAL BATHYMETRY TYPE 2 MATERIAL
-  POTENTIAL LOCATION FOR RIVERLINE FRINGING WETLAND CONSTRUCTION
-  NEARSHORE BORDER (117.5 FEET)
-  NATURAL SHORELINE MODERATE ENERGY (SEE ARCADIS DRAWING ET B-0023)
-  NATURAL SHORELINE LOW ENERGY (SEE ARCADIS DRAWING B-0023)
-  NEARSHORE BORDER SET POINT

NOTES:

1. BACKFILL NOT PLACED WITHIN NAV CHANNEL. ADJUSTED PER AGREEMENT WITH EPA AT 9/11/09 DAILY DATA MEETING..
2. BACKFILL TO BE PLACED IN ACCORDANCE WITH SECTION 13720 AND DESIGN DRAWINGS B-0021 AND B-0020-SK1.
- ~~3. CANDIDATE FOR 15% BACKFILL PLACEMENT, PENDING ORDER OF PRIORITY OF OTHER CUs.~~
3. EPA INFORMED GE ON OCTOBER 12, 2009 THAT PLACEMENT OF 15% BACKFILL WILL NOT BE REQUIRED.
4. EPA AND GE AGREED TO USE TYPE 2 MATERIAL ON A 3:1 SLOPE TO SUPPORT NEARSHORE BACKFILL.


BATHYMETRY USED FROM OSI SURVEY DATE AUGUST 26, 2009


CU-17
1 FOOT BACKFILL PLACEMENT




REV	DATE	DRN BY	DRAWING DESCRIPTION	PM
1	10/16/09	JHG	RECORD DRAWING	MG
0	9/21/09	JHG	ISSUED FOR USE	MG

PARSONS COMMERCIAL TECHNOLOGY GROUP		DRAWING TITLE	
GE COMPANY - PARSONS PROJECT OFFICE BUILDING 40-1, 381 BROADWAY FORT EDWARD, N.Y. 12828 (518) 746-5311		CU17 BACKFILL PLAN	
DRAWN BY JHG	CHECKED BY MG	DRAWING NO. CU17-BC-7 A	VERSION SCALE AS SHOWN
DATE 10/16/09	APPROVED BY MG	JOB 442209.01401	

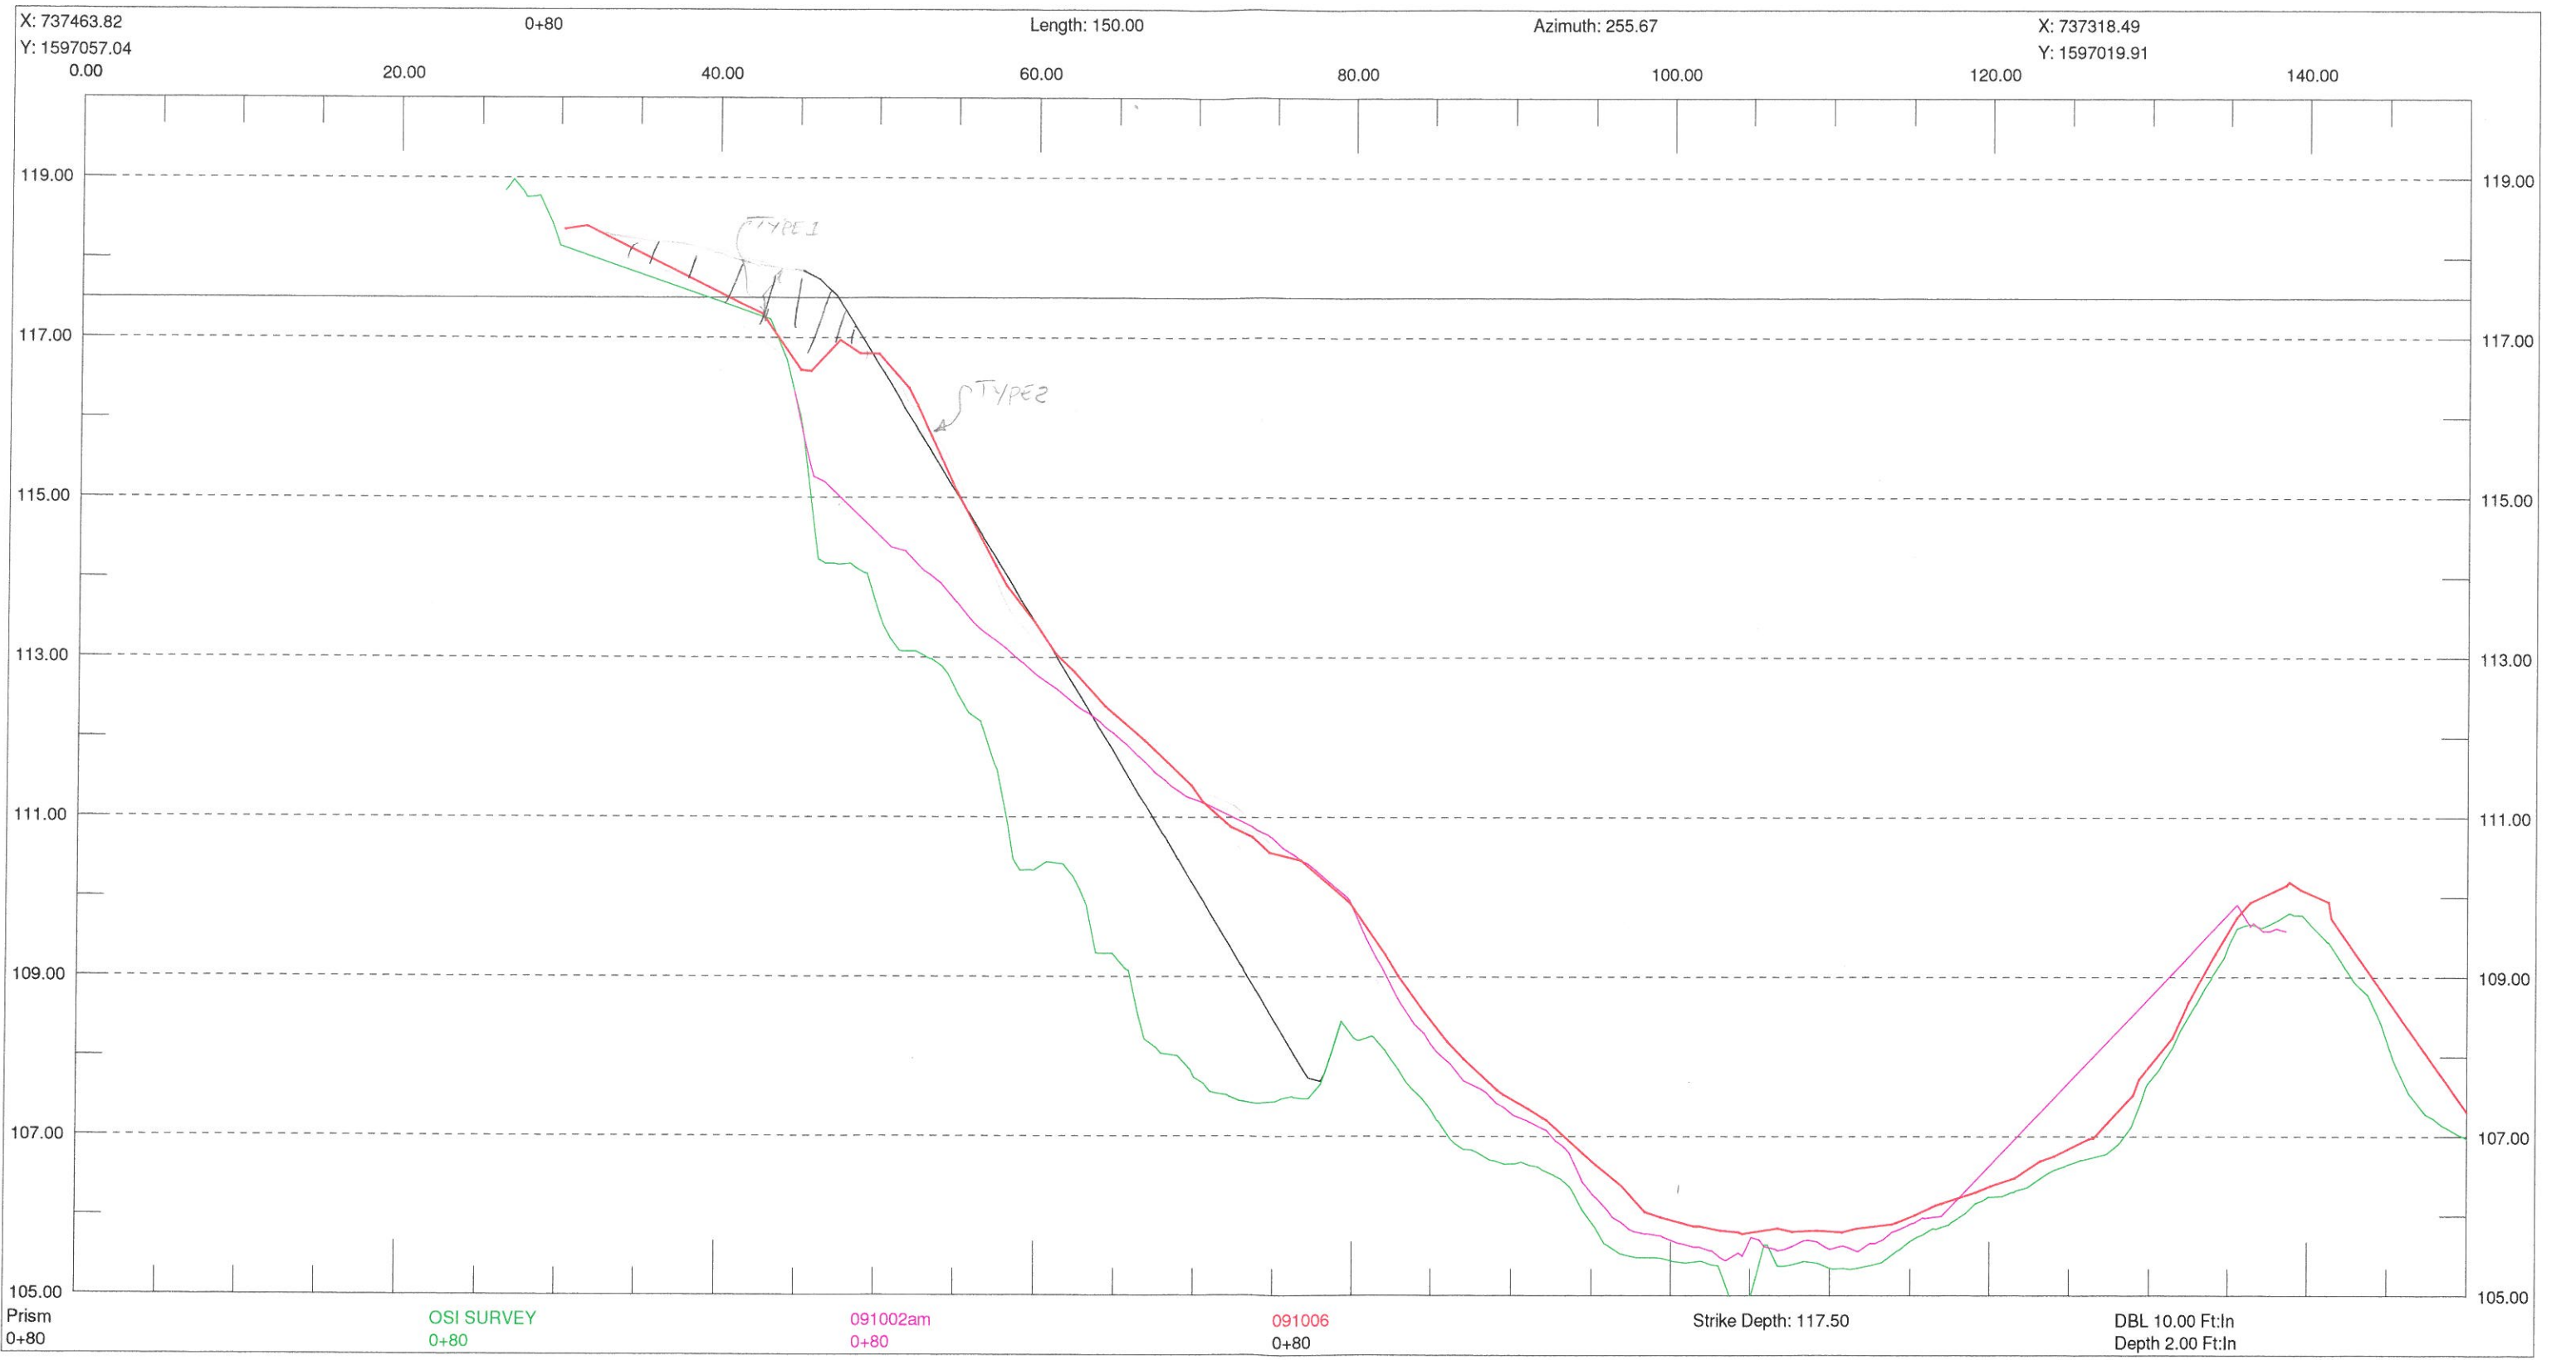

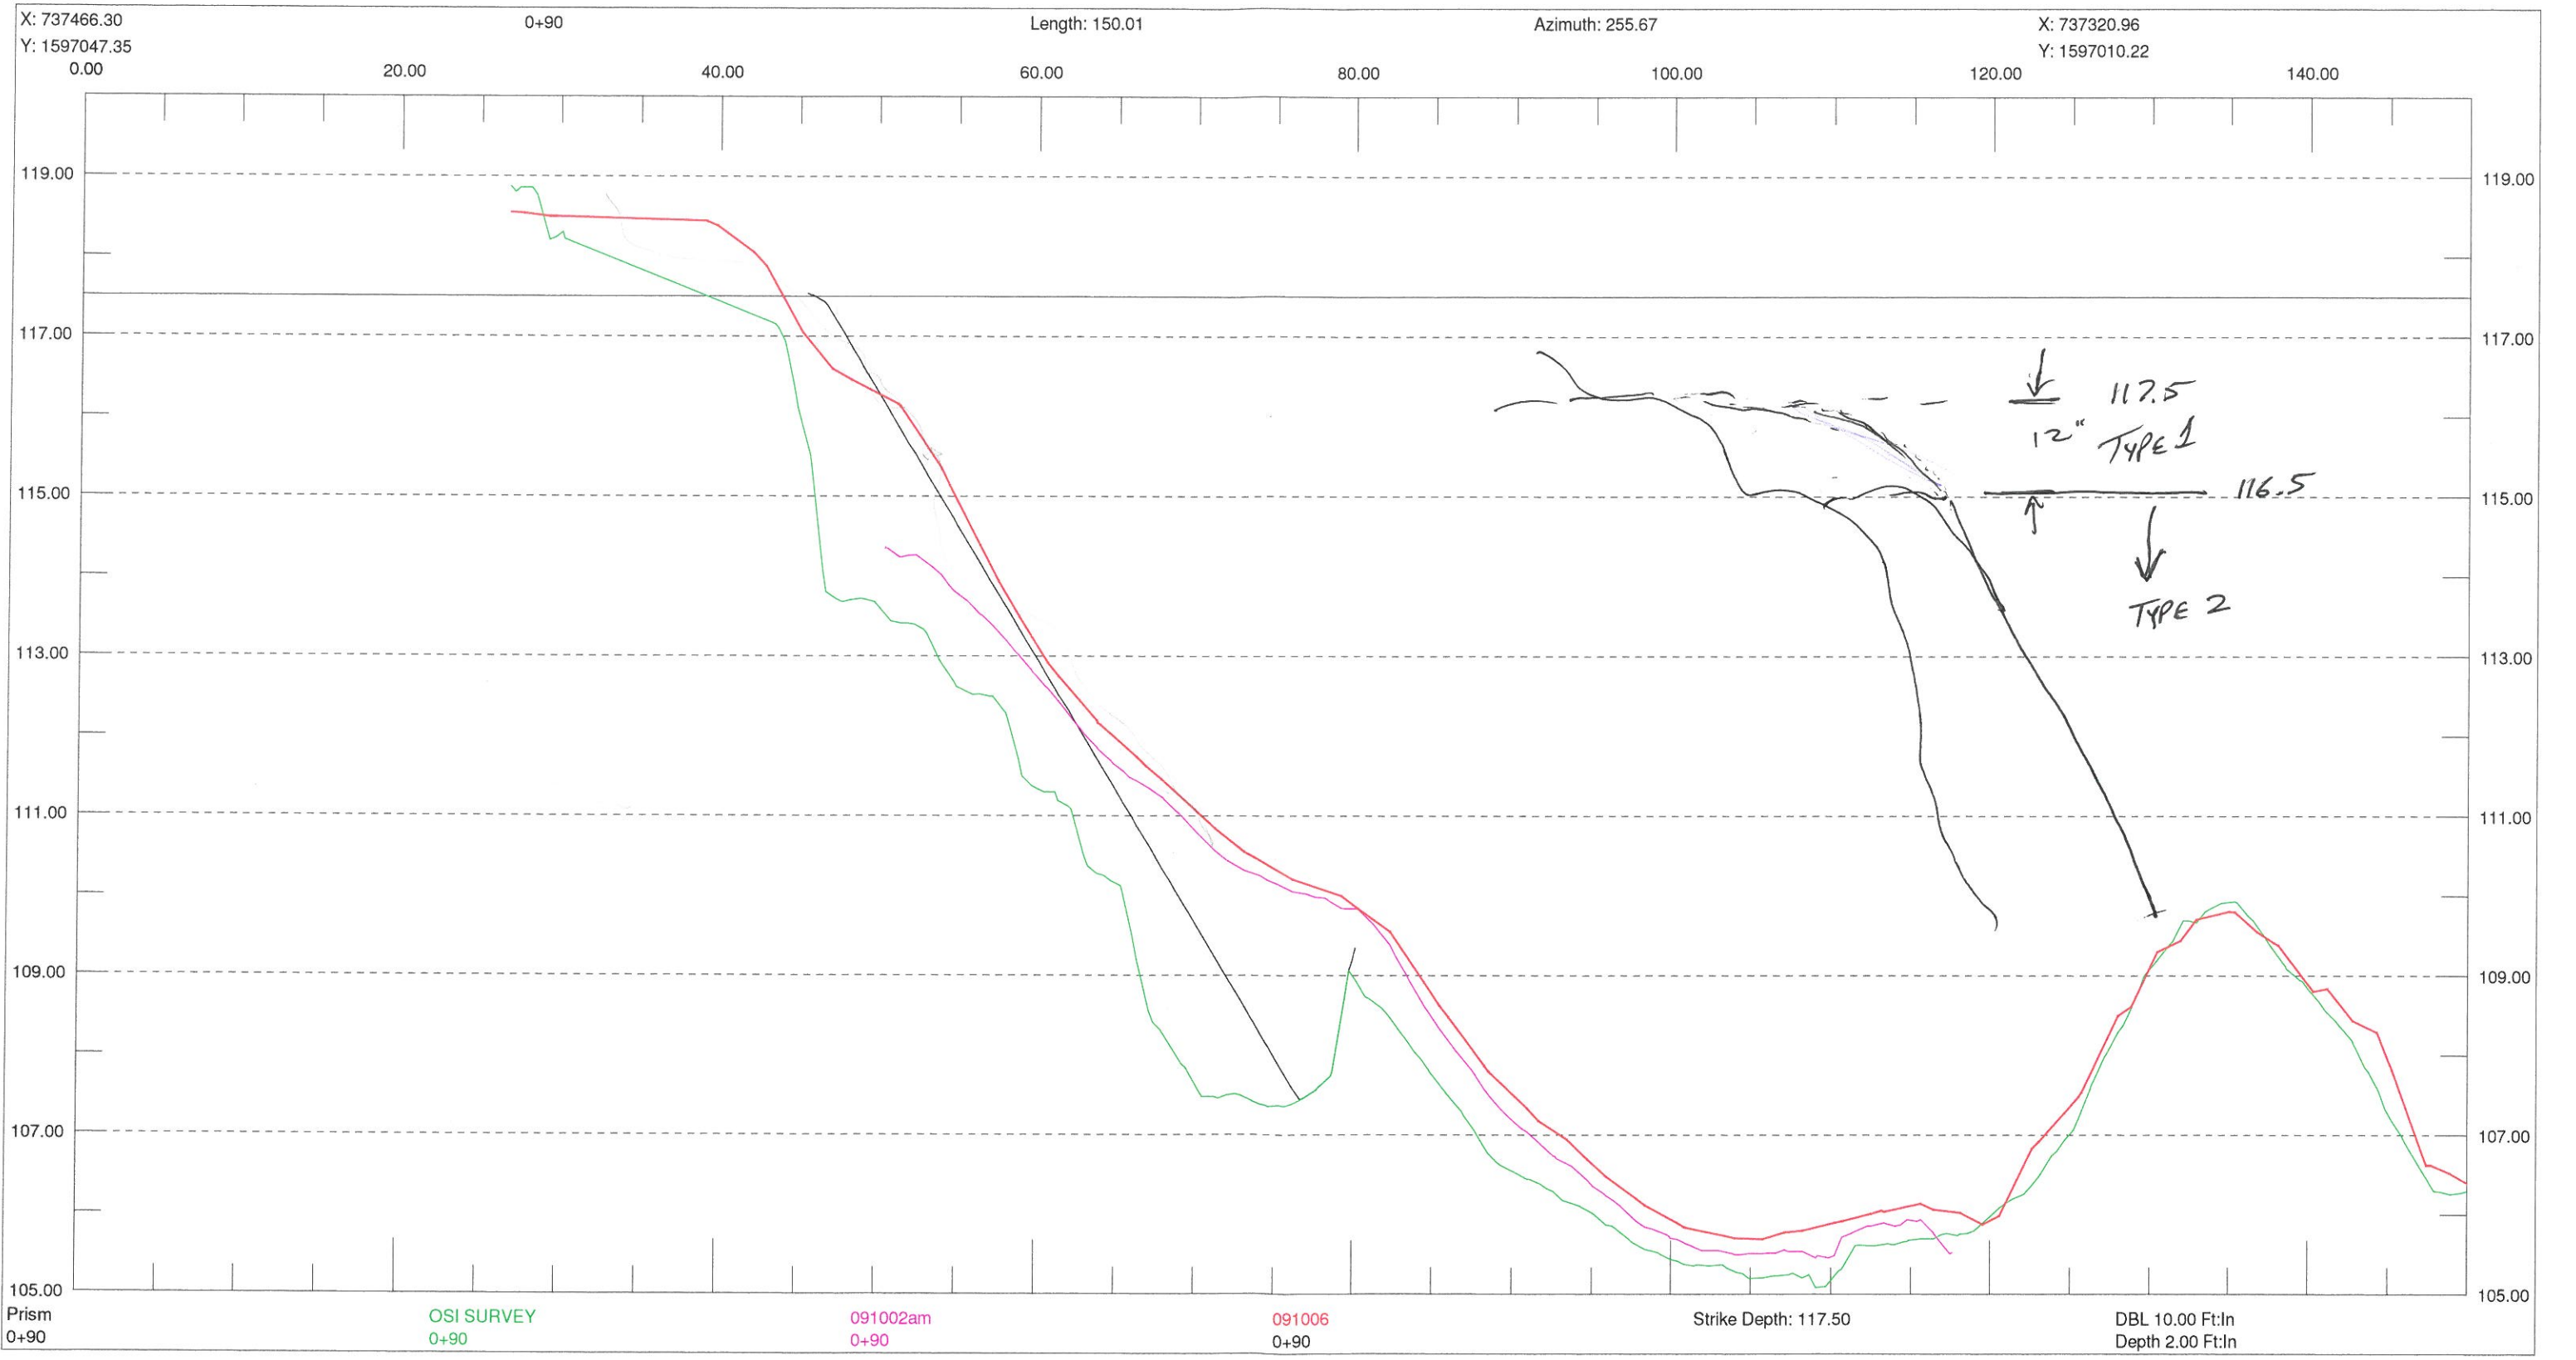

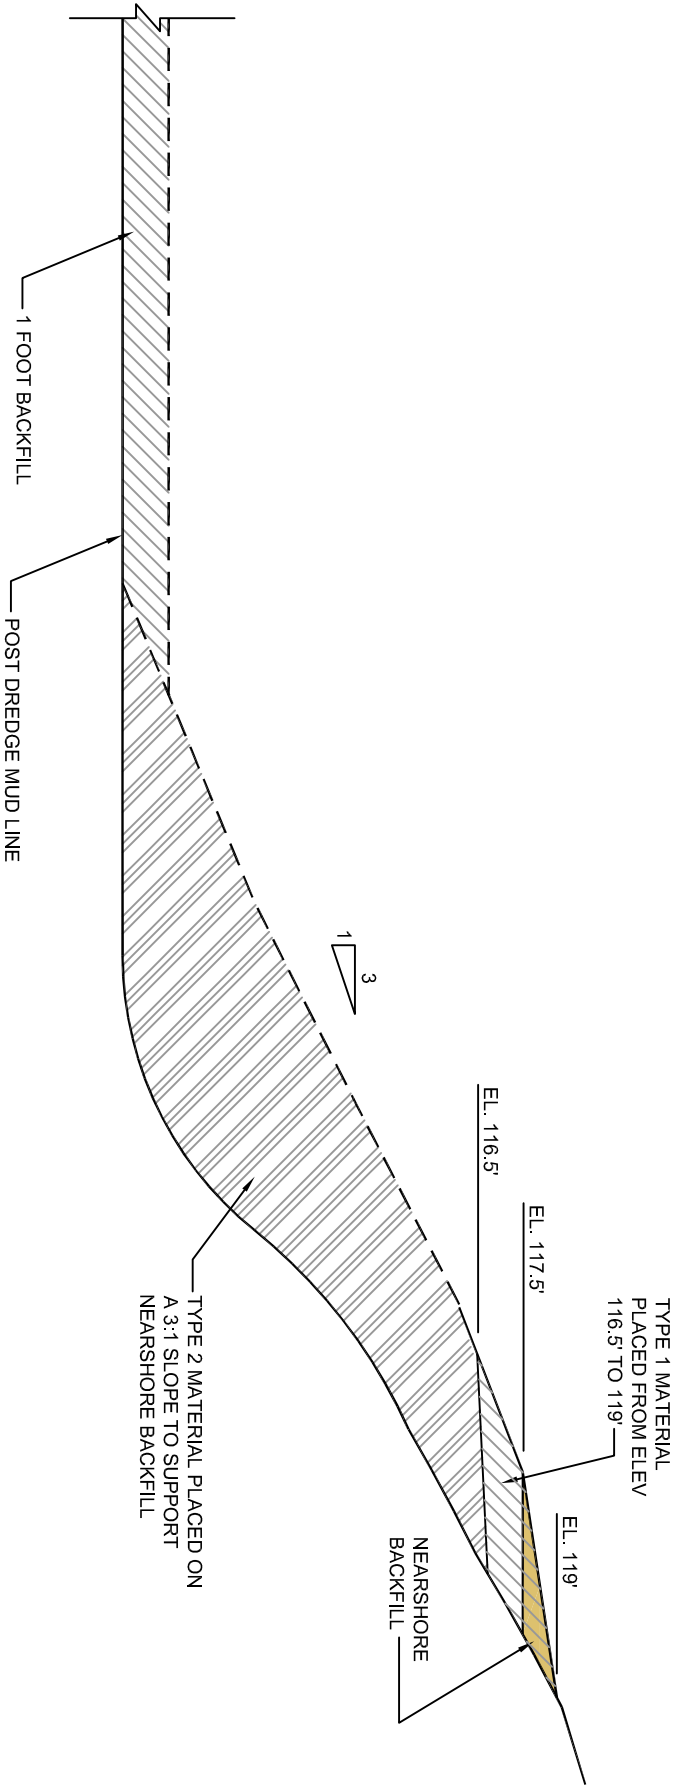

NEAR SHORE BACKFILL PLACEMENT DETAIL

TYPICAL SECTION NOT TO SCALE

COMMERCIAL TECHNOLOGY GROUP GE COMPANY - PARSONS PROJECT OFFICE BUILDING 40-1, 381 BROADWAY FORT EDWARD, N.Y. 12828 (518) 746-5311		DRAWING TITLE PHASE 1 NEAR SHORE BACKFILL PLACEMENT DETAIL	
DRAWN BY JHG	CHECKED BY MG	DRAWING NO. BF-C02	SCALE NOT TO SCALE
DATE 10/14/09	APPROVED BY MG	JOB 442209	

CU-18

Form 2

CU Certification of Completion

CU BACKFILL/ENGINEERED CAP COMPLETION APPROVAL - FORM 2						
Reporting Date	11/19/2009				Placement Start Date	10/29/2009
CU Number	18				Placement End Date	11/14/2009
Approximate CU Centroid	Northing	1595640.203	Easting	737827.314	NY State NAD 83	
CU Size	6.04	Acres				
Backfill Area	4.93	Acres				
Cap Area	1.11	Acres				
Backfill Surface Mean Tri+ PCBs Concentration (when required)		NA		mg/kg		
Number of nodes sampled		NA		mg/kg		
Backfill X	Type of Backfill Type 1, Type 2, Nearshore	Reference to appropriate drawings attached to Approval Form 1 CU18 Backfill and Cap Plan, 10/29/09				
Cap X	Type of Cap Type "A" Low Velocity Cap and Type "A" Medium to High Velocity Cap	Reference to appropriate drawings attached to Approval Form 1 CU18 Backfill and Cap Plan, 10/29/09				
CU Checklist		Indicate one of the following			Reviewer Initial Acceptance	
Item	Attached	Not Applicable	GE	EPA		
Drawing of Installed Backfill/Cap (with record details, thickness and sample locations [when backfill/cap are placed])	x					
Where applicable in backfill areas provide the following: Sample locations (coordinates), depths, Aroclor and Tri+ PCB concentrations collected including analytical data, field observations, (hard copy and electronic copies [in database format or equivalent])		x				
Comments						
Refer to attached Narrative Backfill Summary and CU 18 Backfill Placement Drawing.						
Upon signing this document, GE certifies that the backfill/cap has been installed satisfactorily and that no further backfill placement or capping is required for this CU. These remedial activities exclude long term operation, monitoring, maintenance and adaptive management at the CU. EPA accepts this certification.						
Signature of GE Representative			Signature of EPA Representative			
_____ Signature			_____ Signature			
_____ Name			_____ Name			
_____ Date			_____ Date			

Narrative

CU 18

Narrative Summary of Backfill and Capping and EPA Backfill and Capping Agreements

1.0 Cap Placement

A Type "A" Medium to High Velocity Cap and a Type "A" Low Velocity Cap was placed in accordance with the CU 18 Backfill and Capping Plan Drawing, dated October 29, 2009, which was provided to EPA as part of the CU 18 Form 1 package. A multi-beam bathymetric survey of the CU 18 cap was performed after final cap placement on November 11, 2009, as shown on the attached CU 18 Type "A" Cap Acceptance Survey, dated November 17, 2009. The surveyed cap thickness on a 5' x 5' grid is shown for all cap areas.


2.0 Backfill Placement

Backfill materials were placed in accordance with the CU 18 Backfill and Capping Plan Drawing, dated October 29, 2009, provided to EPA as part of the CU 18 Form 1 package. A multi-beam bathymetric survey for CU 18 was performed after backfill placement on November 15, 2009, as shown on the attached CU 18 Backfill Placement Acceptance Drawing, dated November 17, 2009. The difference to backfill prism on a 10' x 10' grid is shown for all backfill areas.

3.0 EPA Field Agreements Specific to CU 18 Backfill and Capping

1. During the 4:00 PM meeting on October 12, 2009, EPA agreed that acceptance surveys of partial areas of a CU may be performed and used for acceptance once placement of backfill or cap in those areas is complete.
2. During the 3:00 PM meeting on November 12, 2009, GE presented a Cap Acceptance Survey Map on a 5' x 5' grid in CU 18. EPA agreed that the cap thicknesses were acceptable (see attached e-mail, dated November 14, 2009). The CU 18 Type "A" Cap Acceptance Survey Drawing, dated November 14, 2009 is included in this package.
3. On November 18, 2009, GE provided EPA with acceptance surveys of the difference to backfill prisms on a 10' x 10' grid in CU 18. EPA agreed that the top backfill elevations were acceptable on November 18, 2009). The CU 18 Backfill Acceptance Survey Drawing, dated November 17, 2009 is included in this package.

Figures

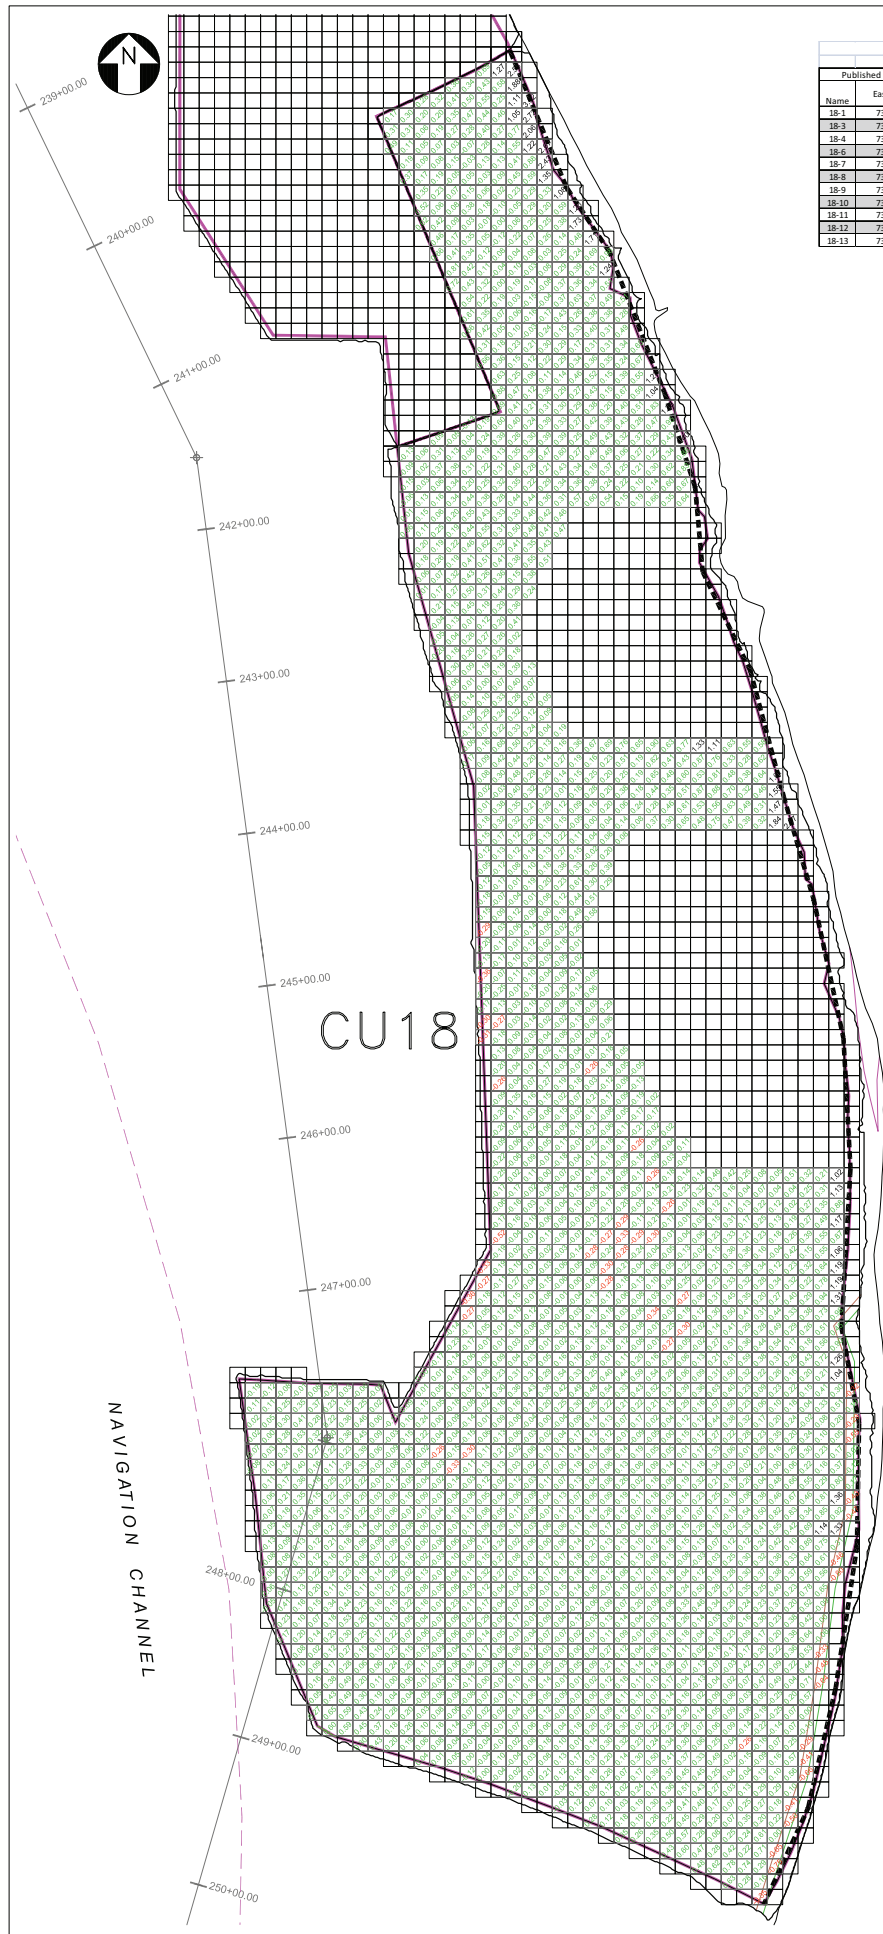

CU-18 Near-Shore Topographic Measurements Collected 2009-11-16									
Published Near-Shore Border Set Points			Near-Shore Topographic Measurements						
Name	Easting	Northing	Target Elevation	Easting	Northing	Check Elevation	Horz. Dist.	Vert. Diff.	
18-1	737,772.26	1,596,347.78	117.50	737,772.27	1,596,347.84	117.82	0.07	0.32	
18-2	737,809.82	1,596,298.26	117.50	737,809.81	1,596,298.37	117.27	0.14	-0.23	
18-4	737,837.01	1,596,216.08	117.50	737,837.33	1,596,216.21	117.70	0.15	0.20	
18-6	737,872.83	1,596,125.17	117.50	737,872.88	1,596,125.15	117.88	0.06	0.38	
18-7	737,893.00	1,596,063.20	117.50	737,893.09	1,596,063.27	117.62	0.11	0.12	
18-8	737,897.91	1,596,008.17	117.50	737,897.78	1,596,008.31	117.05	0.23	-0.45	
18-9	737,929.00	1,595,943.47	117.50	737,928.95	1,595,943.54	117.49	0.08	-0.01	
18-10	737,951.00	1,595,860.53	117.50	737,951.13	1,595,860.34	117.61	0.23	0.14	
18-11	737,970.23	1,595,794.44	117.50	737,970.26	1,595,794.63	117.91	0.19	0.41	
18-12	737,989.56	1,595,704.45	117.50	737,989.62	1,595,704.60	117.59	0.16	0.09	
18-13	737,994.15	1,595,619.46	117.50	737,994.15	1,595,619.49	117.73	0.03	0.23	

1 ft. Average Thickness Table

Subunit	Average Thickness (ft)	Approx. Area (acre)	Intended Vol. Placed (CY)	Actual Vol. Placed (CY)	Variation from Planned (CY)
CU18-1	1.27	0.87	1407.4	1787.6	380.2
CU18-2 & 18-3	1.14	0.89	1429.6	1634.9	205.3
CU18-4	1.08	0.95	1537.0	1667.6	130.6
CU18-5	1.09	1.05	1700.0	1857.2	157.2
CU18-6	1.17	1.13	1825.9	2143.9	317.9
			Total =	1,191.2	

Notes:
Average thickness and volumes were computed using 10x10 cell center average data sets.

LEGEND


- 10x10 GRID WITHIN DESIGN GUIDELINES
- 10x10 GRID LESS THAN DESIGN GUIDELINES
- 10x10 GRID ABOVE DESIGN GUIDELINES
- MUD - RIP RAP INTERFACE
- 5' INTERFACE OFFSET
- CU BOUNDARY
- NEARSHORE BORDER (117.5 FEET)

NOTES:


1. BATHYMETRY USED OSI MULTIBEAM SURVEY DATE ON NOVEMBER 15, 2009.
2. NUMERIC VALUES IN 10'x10' GRID REPRESENT DIFFERENCE TO TARGET THICKNESS (POSITIVE NUMBERS REFLECT THICKNESS ABOVE TARGET THICKNESS), COLORS DETERMINED USING DIFFERENT BACKFILL TOLERANCES DESCRIBED IN SPEC SECTION 13720.

**CU-18
BACKFILL PLACEMENT ACCEPTANCE
SURVEY**

PARSONS		DRAWING TITLE	
GE COMPANY - PARSONS PROJECT OFFICE		CU18	
BUILDING 40-1, 381 BROADWAY		BACKFILL PLACEMENT	
FORT EDWARD, N.Y. 12059 (518) 746-5311		ACCEPTANCE SURVEY	
DRAWN BY	CHECKED BY	DRAWING NO.	SCALE
JHC	JHC	CU18-1	AS SHOWN
DATE	APPROVED BY		
11/17/09	JHC		

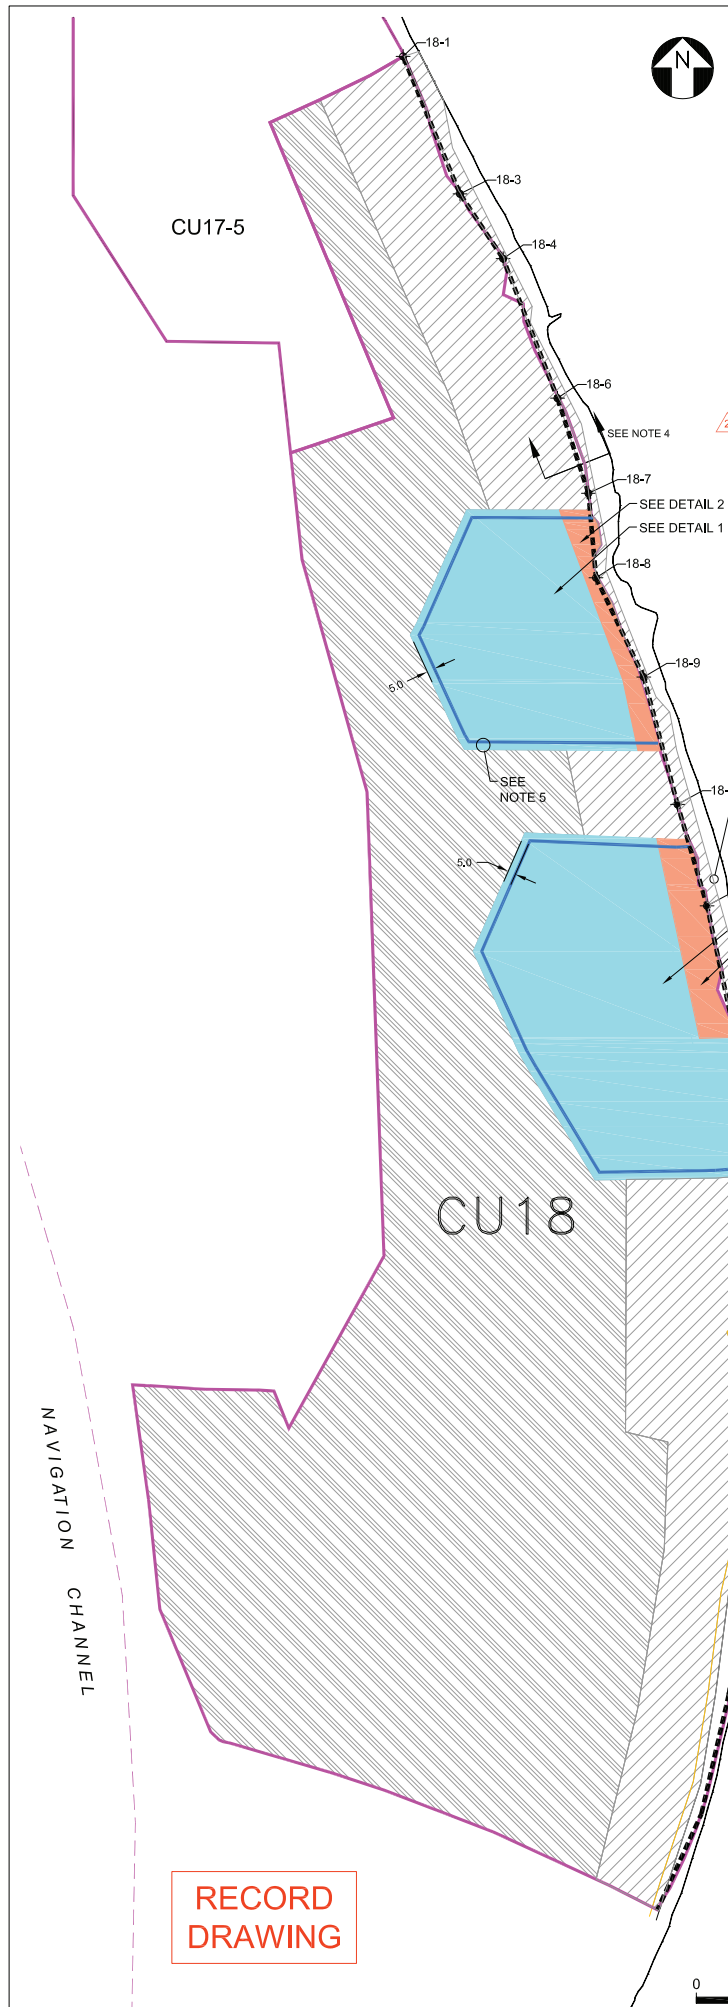


HUDSON RIVER

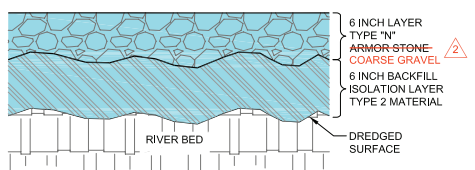

TYPICAL SECTION VIEW

DETAIL 1 - TYPE "A" MEDIUM TO HIGH VELOCITY CAP CU18
NOT TO SCALE

HUDSON RIVER

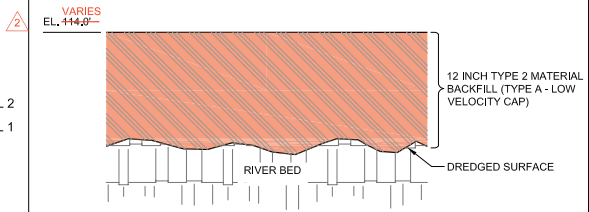

TYPICAL SECTION VIEW

DETAIL 2 - TYPE "A" LOW VELOCITY CAP CU18
NOT TO SCALE

LEGEND	
	CU BOUNDARY
	MUD - RIP RAP INTERFACE
	5' INTERFACE OFFSET
	1 FOOT BACKFILL AND NEARSHORE PLACEMENT TYPE 1 MATERIAL
	1 FOOT BACKFILL AND NEARSHORE PLACEMENT TYPE 2 MATERIAL
	TYPE A - LOW VELOCITY CAP (12" TYPE 2 BACKFILL)
	TYPE A - MEDIUM TO HIGH VELOCITY CAP (6" LAYER OF TYPE 2 BACKFILL & 6" LAYER OF TYPE "N" STONE)
	18-1 NEARSHORE BORDER SET POINT
	POTENTIAL LOCATION FOR RIVERINE FRINGING WETLAND CONSTRUCTION (PLANTING BY OTHERS)
	NEARSHORE BORDER (117.5 FEET)
	LIMIT OF NON-COMPLIANT NODE POLYGONS
	SHORELINE BOUNDARY ELEV. 119'


NOTES:

- BACKFILL TO BE PLACED IN ACCORDANCE WITH SECTION 13720 AND DESIGN DRAWINGS B-0021 AND B-0020-SK1.
- SETPOINTS 18-14 THROUGH 18-20 NOT SHOWN DUE TO RIP-RAP AND RIP-RAP OFFSET.
- BACKFILL TO EXTEND TO EDGE OF RIP-RAP.
- PLACEMENT OF NEARSHORE BACKFILL IN TYPE 1 AREAS TO CONSIST OF TYPE 2 MATERIAL TO ELEV. 116.5', THEN TYPE 1 BACKFILL FROM ELEV. 116.5' TO 119'. (SEE SKETCH CU18-BF-C01).
- TOTAL CAP AREA INCLUDES 5' HORIZONTAL OFFSET INTO COMPLIANT AREA, AS PER CONTRACT DRAWING C-0038.
- EPA HAS ELECTED NOT TO PLACE ANY 15% BACKFILL IN CU18.
- EXISTING WETLAND AREA WAS NOT DISTURBED BY DREDGING ACTIVITY. NO RIVERINE FRINGING WETLAND AREAS ARE PLANNED.

**RECORD
DRAWING**

REV#	DATE	DRN BY	DRAWING DESCRIPTION	MG
2	11/17/09	JHG	RECORD DRAWING	MG
1	10/29/09	JHG	REVISED PER EPA COMMENTS: ISSUED FOR USE	MG
0	10/28/09	JHG	ISSUED FOR EPA REVIEW	MG

PARSONS		DRAWING TITLE	
ENGINEERING COMPANY - PARSONS PROJECT OFFICE		CU18 BACKFILL AND CAPPING PLAN	
BUILDING 40-1, 381 BROADWAY		SCALE AS SHOWN	
FORT EDWARD, N.Y. 12039 (518) 746-5311		JOB 442209.01401	
DRAWN BY	CHECKED BY	DRAWING NO.	SCALE
JHG	MC	CU18-BC-3	AS SHOWN
DATE	APPROVED BY		
11/17/09	MC		

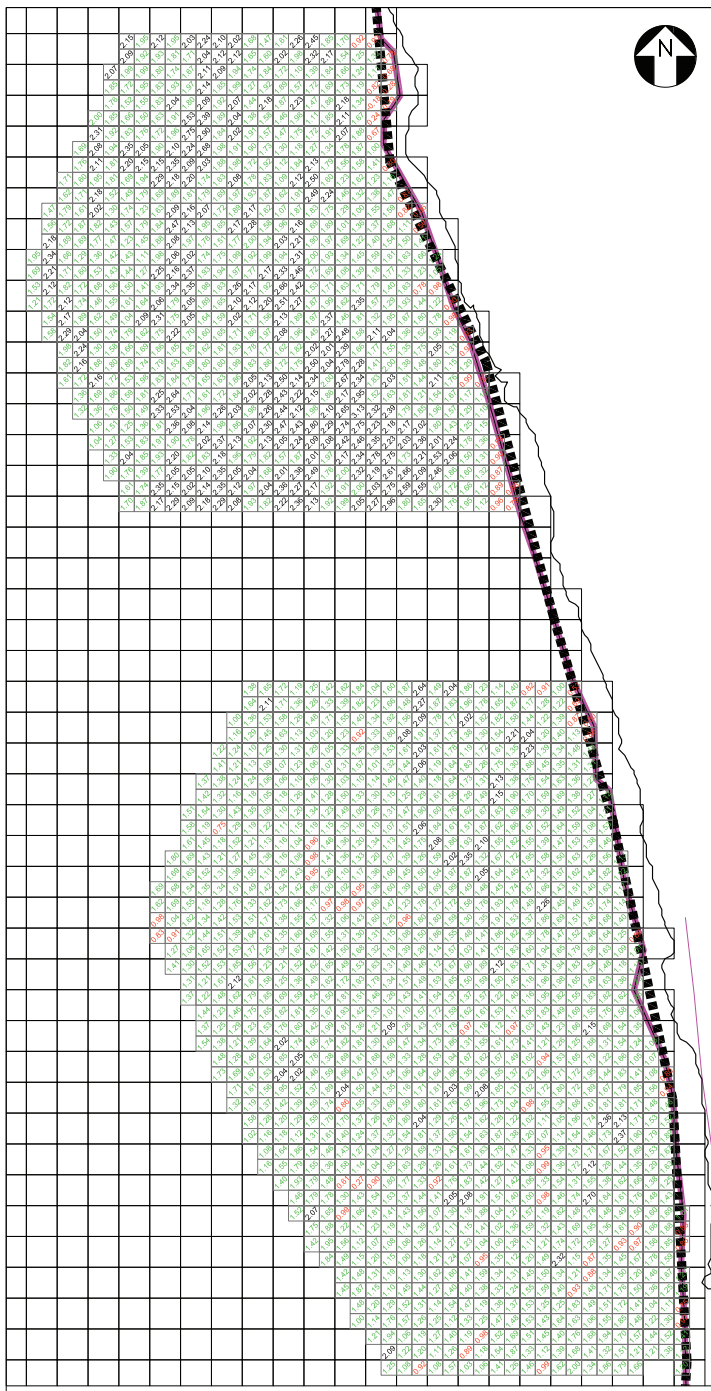

CU18 TYPE A CAP PLACEMENT


NOTES:

1. OSI MULTIBEAM SURVEY ON NOVEMBER 11, 2009.
2. CAP THICKNESS IS LISTED IN 5'x5' GRIDS.

**CU18
TYPE A CAP
ACCEPTANCE SURVEY**

LEGEND


- 5'x5' GRID WITHIN DESIGN GUIDELINES
- 5'x5' GRID LESS THAN DESIGN GUIDELINES
- 5'x5' GRID ABOVE DESIGN GUIDELINES
- CU BOUNDARY
- CU SUBUNIT BOUNDARY
- MUD - RIP RAP INTERFACE
- 5' INTERFACE OFFSET
- NEARSHORE BORDER (117.5 FEET)

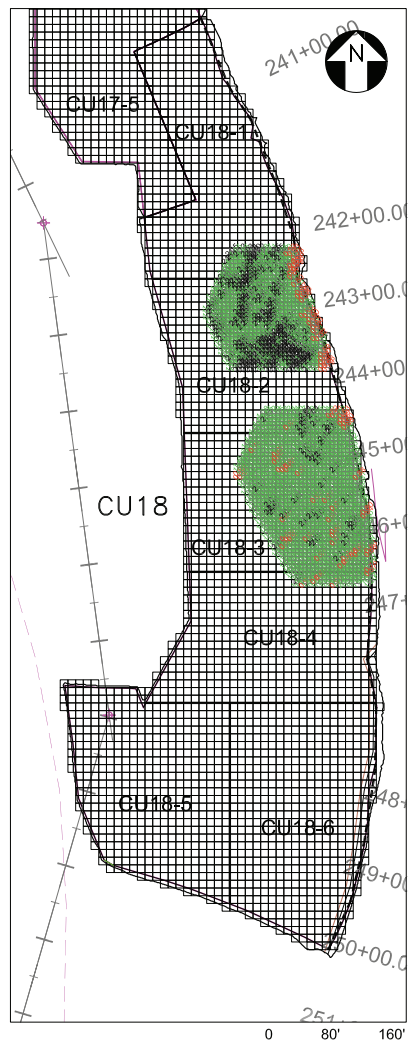

CU18 TYPE A CAP LOCATION


**CU18
1 FOOT BACKFILL PLACEMENT**

REV#	DATE	DRN BY	DRAWING DESCRIPTION	MG
0	11/17/09	JHG	ISSUED FOR EPA REVIEW	MG
DRAWING TITLE				
PARSONS ENGINEERING COMPANY - PARSONS PROJECT OFFICE BUILDING 40-1, 351 BROADWAY FORT EDWARD, N.Y. 12828 (518) 746-5311				
DRAWING NO.			CU18	
SCALE			AS SHOWN	
JOB			442209.01401	

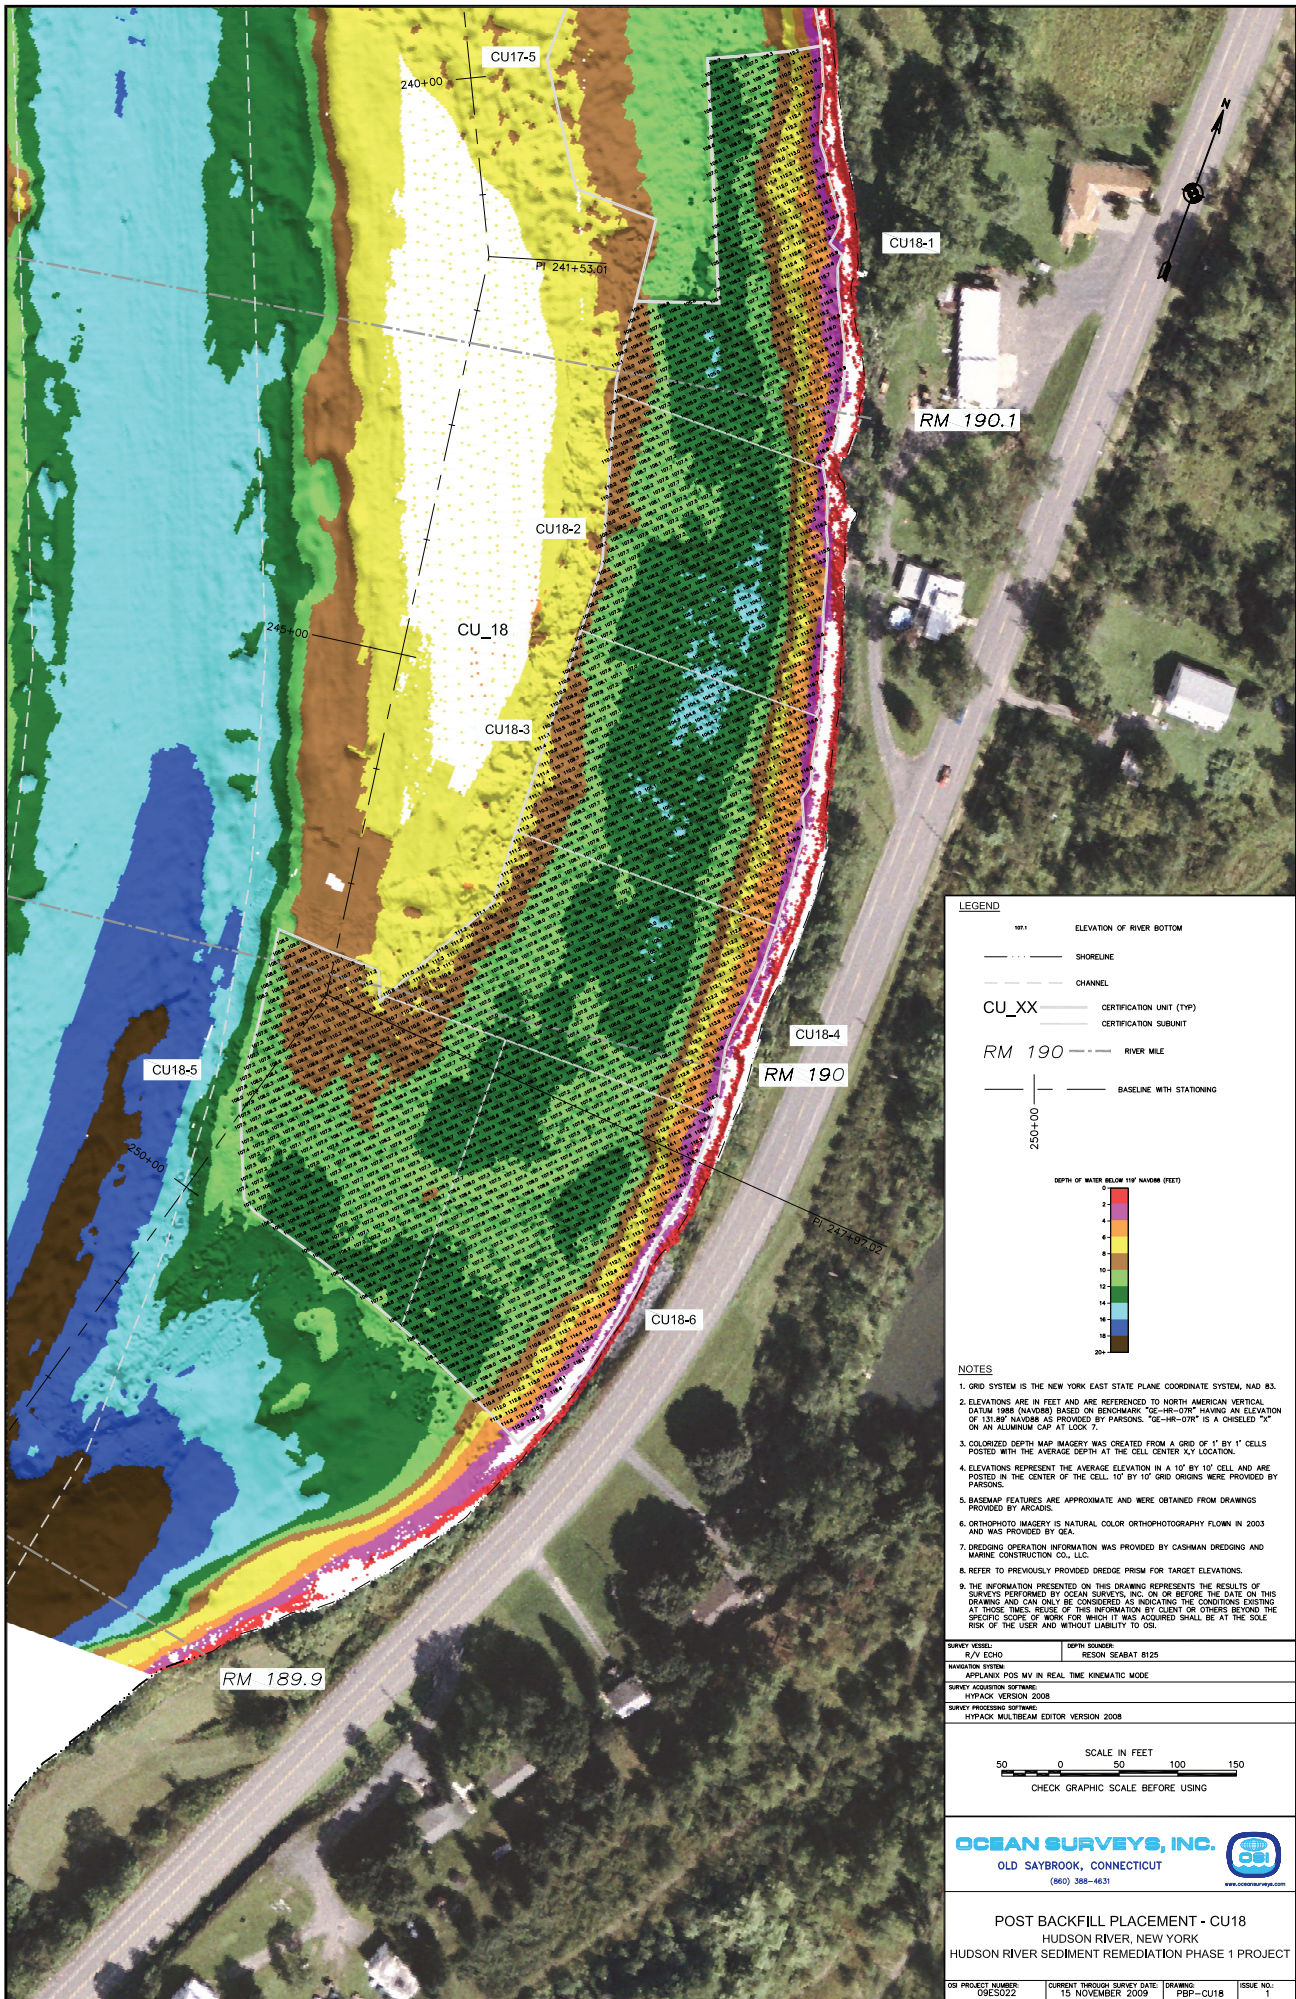

LEGEND


- ELEVATION OF RIVER BOTTOM
- SHORELINE
- CHANNEL
- CU_XX --- CERTIFICATION UNIT (TYP)
- CERTIFICATION SUBUNIT
- RM 190 --- RIVER MILE
- BASELINE WITH STATIONING

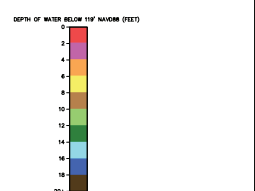

NOTES

1. GRID SYSTEM IS THE NEW YORK EAST STATE PLANE COORDINATE SYSTEM, NAD 83.
2. ELEVATIONS ARE IN FEET AND ARE REFERENCED TO NORTH AMERICAN VERTICAL DATUM 1988 (NAVD83) BASED ON BENCHMARK "02-HR-07R" HAVING AN ELEVATION OF 13.87' NAVD83 AS PROVIDED BY PARSONS. "02-HR-07R" IS A CHISELED "C" ON AN ALUMINUM CAP AT LOCK 7.
3. COLORIZED DEPTH MAP IMAGERY WAS CREATED FROM A GRID OF 1' BY 1' CELLS POSTED WITH THE AVERAGE DEPTH AT THE CELL CENTER "X,Y" LOCATION.
4. ELEVATIONS REPRESENT THE AVERAGE ELEVATION IN A 10' BY 10' CELL AND ARE POSTED IN THE CENTER OF THE CELL. 10' BY 10' GRID ORIGINS WERE PROVIDED BY PARSONS.
5. BATHYMAP FEATURES ARE APPROXIMATE AND WERE OBTAINED FROM DRAWINGS PROVIDED BY ARCADIS.
6. ORTHOPHOTO IMAGERY IS NATURAL COLOR ORTHOPHOTOGRAPHY FLOWN IN 2003 AND WAS PROVIDED BY SEA.
7. DREDGING OPERATION INFORMATION WAS PROVIDED BY CASHMAN DREDGING AND MARINE CONSTRUCTION CO., LLC.
8. REFER TO PREVIOUSLY PROVIDED DREDGE PRISM FOR TARGET ELEVATIONS.
9. THE INFORMATION PRESENTED ON THIS DRAWING REPRESENTS THE RESULTS OF SURVEYS PERFORMED BY OCEAN SURVEYS, INC. ON OR BEFORE THE DATE OF THIS DRAWING AND CAN ONLY BE CONSIDERED AS INDICATING THE CONDITIONS EXISTING AT THOSE TIMES. REUSE OF THIS INFORMATION BY CLIENT OR OTHERS BEFORE THE SPECIFIC SCOPE OF WORK FOR WHICH IT WAS ACQUIRED SHALL BE AT THE SOLE RISK OF THE USER AND WITHOUT LIABILITY TO OSI.


SURVEY VESSEL	R/V ECHO	DEPTH SOUNDER	RESON SEABAT 8125
NAVIGATION SYSTEM	APOLANIX POS MV IN REAL TIME KINEMATIC MODE		
SURVEY ACQUISITION SOFTWARE	HYPPACK VERSION 2008		
SURVEY PROCESSING SOFTWARE	HYPPACK MULTIBEAM EDITOR VERSION 2008		

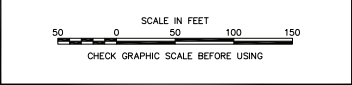

OCEAN SURVEYS, INC.
 OLD SAYBROOK, CONNECTICUT
 (860) 388-4631

POST BACKFILL PLACEMENT - CU18
 HUDSON RIVER, NEW YORK
 HUDSON RIVER SEDIMENT REMEDIATION PHASE 1 PROJECT

OS PROJECT NUMBER	OS20022	CURRENT THROUGH SURVEY DATE	15 NOVEMBER 2009	DRAWING	PBP-CU18	ISSUE NO.	1
-------------------	---------	-----------------------------	------------------	---------	----------	-----------	---

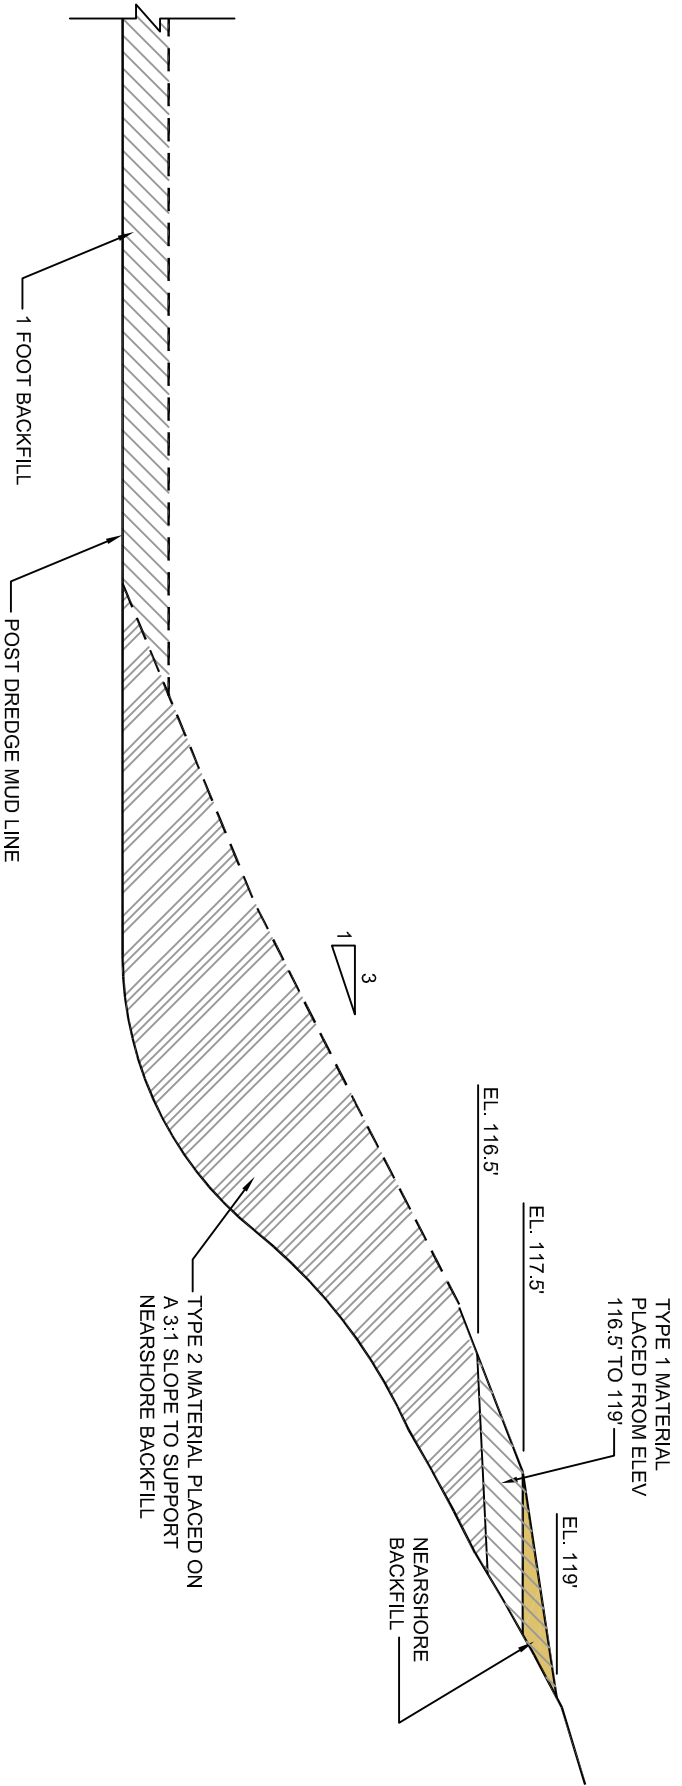

NEAR SHORE BACKFILL PLACEMENT DETAIL

TYPICAL SECTION NOT TO SCALE

RECORD
DRAWING

PARSONS <small>COMMERCIAL TECHNOLOGY GROUP</small>		DRAWING TITLE CU18 NEAR SHORE BACKFILL PLACEMENT DETAIL	
GE COMPANY - PARSONS PROJECT OFFICE BUILDING 40-1, 381 BROADWAY FORT EDWARD, N.Y. 12828 (518) 746-5311		DRAWING NO. CU18-BF-C01	
DRAWN BY JHG	CHECKED BY MG	SCALE NOT TO SCALE	JOB 442209
DATE 11/05/09	APPROVED BY MG		

Correspondence
(Letters and Emails)

Galbraith, Michael

From: King.David@epamail.epa.gov
Sent: Saturday, November 14, 2009 9:36 AM
To: Andrew Inglis
Cc: Michael J. Johnson; Timothy Kruppenbacher; Galbraith, Michael; Bryan Minor; Gary Klawinski; Joseph Moloughney
Subject: Re: Discussions regarding CU Backfill and Cap placement

Andrew, I agree with summary.

Dave

Sent by EPA Wireless E-Mail Services

From: "Inglis, Andrew A (GE, Corporate)" [andrew.inglis@ge.com]
Sent: 11/13/2009 05:13 PM EST
To: David King
Cc: <MJohnson@louisberger.com>; "Kruppenbacher, Timothy A (GE, Corporate)" <timothy.kruppenbacher@ge.com>; <michael.galbraith@parsons.com>; <USACE_HRFO@roadrunner.com>; <GKlawinski@ene.com>; "Joseph Moloughney" <Joseph_Moloughney@canals.state.ny.us>
Subject: Discussions regarding CU Backfill and Cap placement

Dave,

Today and yesterday we met and reviewed progress surveys of cap and backfill placement in CUs 1, 2, 3, 4, 7 and 18. This email confirms decisions made during the meeting based on reviews of the maps presented during the meeting.

CU1.

In CU1 it was agreed that sufficient thickness of isolation layer material has been placed while providing enough room to place armor stone below the 105.2' elevation in the navigation channel. It was agreed that placement of armor stone can begin.

CU2.

In CU2 it was agreed that the top of cap and backfill elevations were acceptable. GE will prepare a Form 2 package for EPA review.

CU3 .

In CU3 it was agreed that the top of cap and backfill elevations were acceptable, it was discussed that GE was in the process of placing backfill in an area of the navigation channel where the post dredge elevations were below 102' elevation. Once GE has surveyed that additional backfill location GE will prepare a Form 2 package for EPA review.

CU4.

In CU4 it was agreed that the top of cap elevations in the north east quarter of the CU was acceptable and that backfill placement in that area may begin.

CU7.

In CU7 it was agreed that the top of cap and backfill elevations were acceptable. GE will prepare a Form 2 package for EPA review.

CU18

In CU18 it was agreed that the top of cap elevations were acceptable in both of the cap locations in that CU.

Please let me know if I missed anything.

Thanks,

Andrew A. Inglis
Dredging Task Leader
GE

T +1 518-746-5256

381 Broadway
Building 40-2
Fort Edward, NY 12828
GE Corporate Environmental Programs

GE Imagination at Work