



ONE OF THESE TWO CLARIFIERS TO BE USED FOR STORAGE OF EFFLUENT DURING CUT-IN OF THE EFFLUENT LINE FOR BYPASSING. BIDDERS MUST ASSESS EXISTING CONDITIONS, INHERENT DIFFICULTIES AND DETAILED INFORMATION SUCH AS EXISTING INFLUENT FLOWS AT CERTAIN TIMES IN ORDER TO ESTIMATE AVAILABLE DURATION AND TIME TO ACCOMPLISH BYPASS CONNECTIONS.

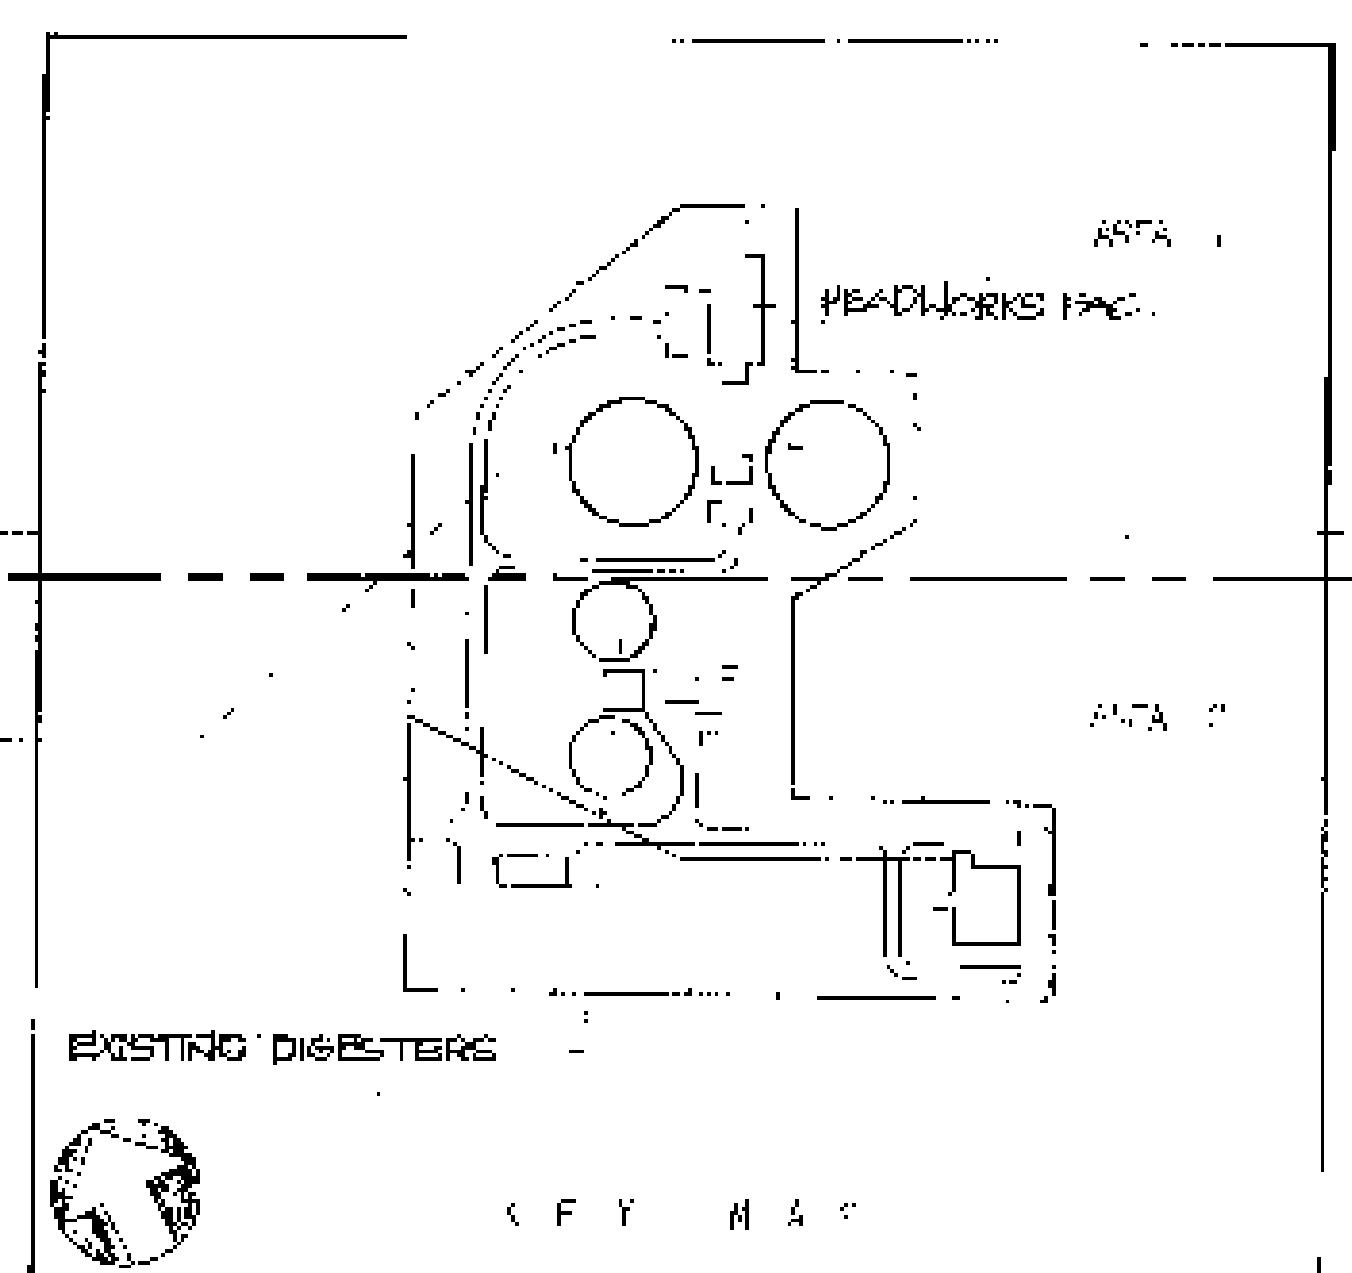

### TREATMENT PLANT SITE AS-BUILT & EFFLUENT LINE LAYOUT PLAN

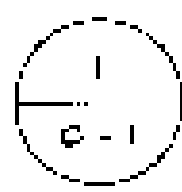


SCALE 1" = 20' - 0"

SUBMITTING CONSTRUCTION CO. LTD.  
AS-BUILT DRAWING

The certifier that the dimensions and details shown on this sheet reflect the as-constructed and details as constructed in the field.

Signature: \_\_\_\_\_ Date: 4/1/99

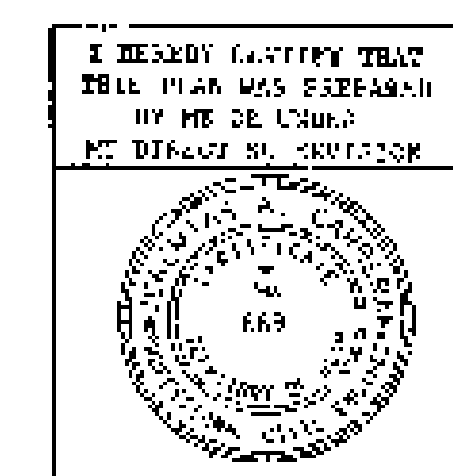

REV.	DATE	BY	DESCRIPTION	APPROVED
<b>PACIFIC ISLAND ENGINEERS</b> <small>ENGINEERS &amp; PLUMBERS #0-04            REGISTERED PROFESSIONAL ENGINEERS            P. O. BOX 4000, HAGATNA, GUAM 96931            TEL. NO. 848-7431/23 FAX NO. 848-1282</small>				
<b>DES. CEC</b> <b>DRN. CEC</b> <b>CHK./IAC/VEP</b> <b>SUPV. JAC</b>			<b>GOVERNMENT OF GUAM</b> <b>GUAM WATERWORKS AUTHORITY</b>	
<b>SUBMITTED BY:</b> _____ <b>DATE:</b> _____			<b>NORTHERN DISTRICT SEWERAGE SYSTEM</b> <b>EFFLUENT FORCE MAIN REPLACEMENT</b>	
<b>VIRGILIO NICOLAS</b> <b>PROJECT ENGINEER</b>			<b>RECOMMENDED BY:</b> _____ <b>DATE:</b> _____ <b>JOB ORDER NO.:</b> _____	
<b>RENATO ALCAZAREN</b> <b>PROJECT MANAGER</b>			<b>QUIRINO H. BASBAS, P.E.</b> <b>CHIEF ENGINEER</b>	
<b>SCALE:</b> PUAG DWG. NO. _____			<b>DRAWING NO.:</b> C-1 <b>SHT. 4 OF 11</b>	